

State Geological Survey
WICHITA, BRANCH

KANSAS DRILLERS LOG

S. 33 T. 12S R. 17X
W

API No. 15 — 051 — 20,875
County Number

Loc. NW SW NW

County Ellis

Operator
Beacon Resources Corporation,

Address
Suite 1000 Century Plaza, Wichita, Ks. 67202

Well No. 1 Lease Name Walter Staab


Footage Location
990 feet from ~~XX~~ (S) line 330 feet from ~~XX~~ (W) line

Principal Contractor Dreiling Oil, Inc. Geologist Robert E. McCann

Spud Date 12/8/72 Total Depth 3671 P.B.T.D. --

Date Completed 1/9/73 Oil Purchaser Clear Creek

640 Acres
N

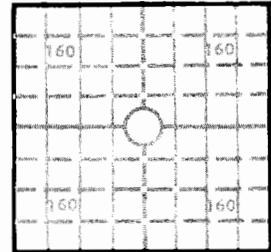

Locate well correctly

Elev.: Gr. 2133

DF 2135 KB 2138

CASING RECORD

Report of all strings set — surface, intermediate, production, etc.

Purpose of string	Size hole drilled	Size casing set (in O.D.)	Weight lbs/ft.	Setting depth	Type cement	Sacks	Type and percent additives
surface	12-1/4	8-5/8		246		165	
production		5-1/2		3662	salt sat. common	50	

LINER RECORD

PERFORATION RECORD

Top, ft.	Bottom, ft.	Sacks cement	Shots per ft.	Size & type	Depth interval
--	--	--	--	--	--

TUBING RECORD		
Size	Setting depth	Packer set at
--	--	--

ACID, FRACTURE, SHOT, CEMENT SQUEEZE RECORD

Amount and kind of material used	Depth interval treated
1000 gal Haliburton 20-2 mod	3637-3662

INITIAL PRODUCTION

Date of first production <u>1/18/73</u>	Producing method (flowing, pumping, gas lift, etc.) <u>pumping</u>			
RATE OF PRODUCTION PER 24 HOURS	Oil <u>8</u> bbls.	Gas <u>--</u> MCF	Water <u>--</u> bbls.	Gas-oil ratio <u>--</u> CFPB
Disposition of gas (vented, used on lease or sold) <u>--</u>			Producing interval (s) <u>3659-3662</u>	

INSTRUCTIONS: As provided in KCC Rule 82-2-125, within 90 days after completion of a well, one completed copy of this Drillers Log shall be transmitted to the State Geological Survey of Kansas, 4150 Monroe Street, Wichita, Kansas 67209. Copies of this form are available from the Conservation Division, State Corporation Commission, 3830 So. Meridian (P.O. Box 17027), Wichita, Kansas 66217. Phone AC 316-522-2206. If confidential custody is desired, please note Rule 82-2-125. Drillers Logs will be on open file in the Oil and Gas Division, State Geological Survey of Kansas, Lawrence, Kansas 66044.

Operator

Beacon Resources Corporation

DESIGNATE TYPE OF COMP.: OIL, GAS,
DRY HOLE, SWDW, ETC.:
oil

Well No.

1

Lease Name

Walter Staab

S 33 T 12S R 17E
W

WELL LOG

Show all important zones of porosity and contents thereof; cored intervals, and all drill-stem tests, including depth interval tested, cushion used, time tool open, flowing and shut-in pressures, and recoveries.

SHOW GEOLOGICAL MARKERS, LOGS RUN, OR OTHER DESCRIPTIVE INFORMATION.

FORMATION DESCRIPTION, CONTENTS, ETC.

TOP

BOTTOM

NAME

DEPTH

DST #1 3418-3440, rec 70' wtry mud,
spots oil on top, BHP 508-413,
FP 11-42.

DST #2 3440-3477, rec 20' mud w/
few spots oil, BHP 63-42, FP
21-32.

DST #3 3454-3492, rec 10' mud,
BHP 21-21, FP 21-21.


DST #4 3641-3665, rec 60' OCM, 60'
HO CM, 60' mdy oil, 60' SMO. BHP
925-748, FP 21-89.

DST #5 3665-3671, rec 780' clean
oil, 90' mdy oil, BHP 841-644,
FP 11-328.

Sample tops:

ANHYDRITE 1354
TOPEKA 3097
HEEBNER 3354
TORONTO 3376
LANSING 3400
B/KC 3643
ARBUCKLE 3659
RTD 3671

USE ADDITIONAL SHEETS, IF NECESSARY, TO COMPLETE WELL RECORD.

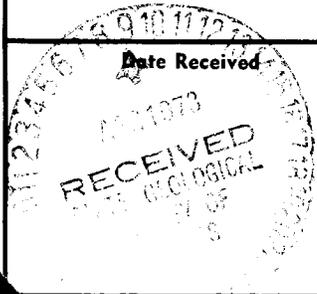

A. L. Rawley, Jr.
Signature

Manager of Production

Title

3/12/73

Date

3-12-73