

Ellis

KANS.

Sec. 32 Twp. 12 R. 17W

Well No. #1 Herman Farm

H. H. Blair Company


Wildcat (Blair, Contr.)

\_\_\_\_\_ Ft. from N. Line

990' Ft. from S. Line

\_\_\_\_\_ Ft. from E. Line

330' Ft. from W. Line

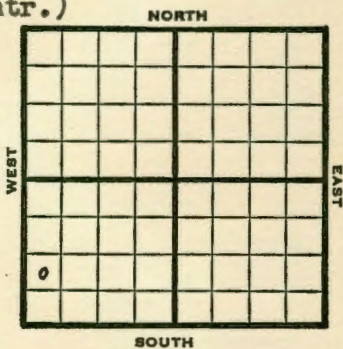

NW SW SW

1949 **Elev. 2042'** REPORT

12/14 Location

12/21 8" @ 143'

12/28 " "

1950

1/25 8" @ 143'

Anhy 1265'

Heeb 3272'

Lans 3323'

Congl 3615'

Tor 3300'

TD 3798'

**ABANDONED**


Ellis

KANSAS

Section 32 Township 12 Range 17W

Well No. #1 Herman

Company H. H. Blair  
Wildcat

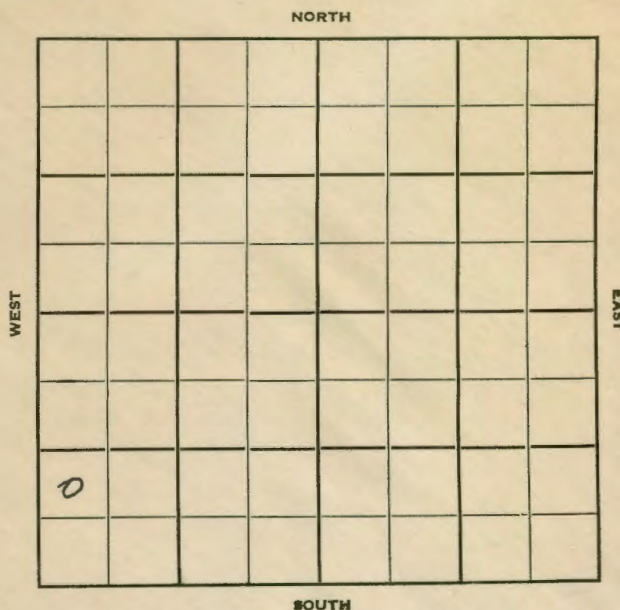

SOUTH

Kansas

Map No. \_\_\_\_\_ Sec. 32 Twp. 12 R. 17W

Well No. 1 Herman

H. H. Blair Company

Blair Contractor

NW SW SW

FIRST REPORT SECTION PLAT

\_\_\_\_\_ Ft. from N. Line

990 Ft. from S. Line

\_\_\_\_\_ Ft. from E. Line

330 Ft. from W. Line


Ellis County

Location X

Rig up \_\_\_\_\_

Drilling and Remarks:

RECORD

Cased \_\_\_\_\_ in., \_\_\_\_\_ ft.

Sand \_\_\_\_\_

Gas \_\_\_\_\_

Oil \_\_\_\_\_

Total Depth \_\_\_\_\_

PRODUCTION

1st 24 hrs. Nat. \_\_\_\_\_

1st 24 hrs. after shot \_\_\_\_\_

Gas \_\_\_\_\_ Cu. Ft.

Dry Hole \_\_\_\_\_

Abandoned \_\_\_\_\_

Date

DEC 14 1949 19

S. J. LEWIS Scout

Map No. \_\_\_\_\_ Sec. 32 Twp. 12 R. 17W

Well No. 1 Herman

H. H. Blair Company

NW SW SW

Fl. 2042 SECTION PLAT

\_\_\_\_\_ Ft. from N. Line

990 Ft. from S. Line

\_\_\_\_\_ Ft. from E. Line

330 Ft. from W. Line

ABANDONED			
o			

Ellis County

Location \_\_\_\_\_

Rig up \_\_\_\_\_

Drilling and Remarks:

8" @ 143  
anh 1265  
bub 3272  
Top 3300  
Lens 3323  
Cong. 3615

RECORD

Cased \_\_\_\_\_ in., \_\_\_\_\_ ft.

Sand \_\_\_\_\_

Gas \_\_\_\_\_

Oil \_\_\_\_\_

Total Depth 3798

PRODUCTION

1st 24 hrs. Nat. \_\_\_\_\_

1st 24 hrs. after shot \_\_\_\_\_

Gas \_\_\_\_\_ Cu. Ft.

Dry Hole \_\_\_\_\_

Abandoned \_\_\_\_\_

Date

JAN 25 1950

D+A

J. E. TYRA Scout