


Section 32 Township 12 Range 17W

Well No. #2 Staab

Company Sunray

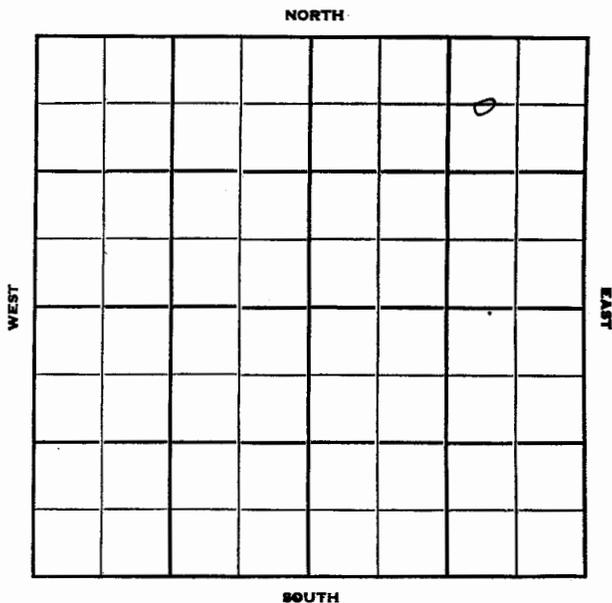


Sec. 32 Twp. 12 R. 17W

Well No. #2 Staab Farm

Sunray Company

Stickle Drlg. - Contr. Contractor

660' Ft. from N. Line
 _____ Ft. from S. Line
990' Ft. from E. Line
 _____ Ft. from W. Line

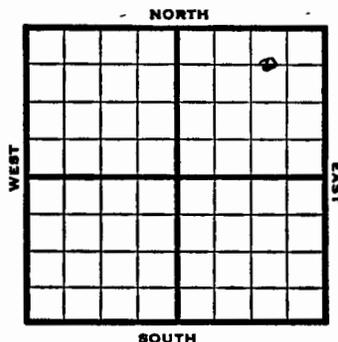

C W/2 NE NE

1952	Elev. 2124'	REPORT
1/23	RUR	
2/6	Arb. 3684	DST 3686-87, 1 hr. 30' oily mud 240# BPH RTD 3689 5" @ 3685'
2/13	Simp 3665	CO to 3689 300 A PB 2186
2/20	CO DD 3693'	300 A Test SSO & W DD 3699' Test 4 BW DD 3703' TD Test 45 gal oil plus 15 BWPH
2/27	Spud 1-24-52	
	Abd. TD 3703	
	8" @ 1358	
	Simp. 3665	Arb. 3684
	DST 3686-89	open 1 hr. rec. 30' oily mud 5" @ 3685 TD 3689 300 A PB 2186 CO DD 3693 500 A SSO & wtr. DD 3699 4 bwph DD 3703 45 go 15 bwph Temp. abd.

ABANDONED

