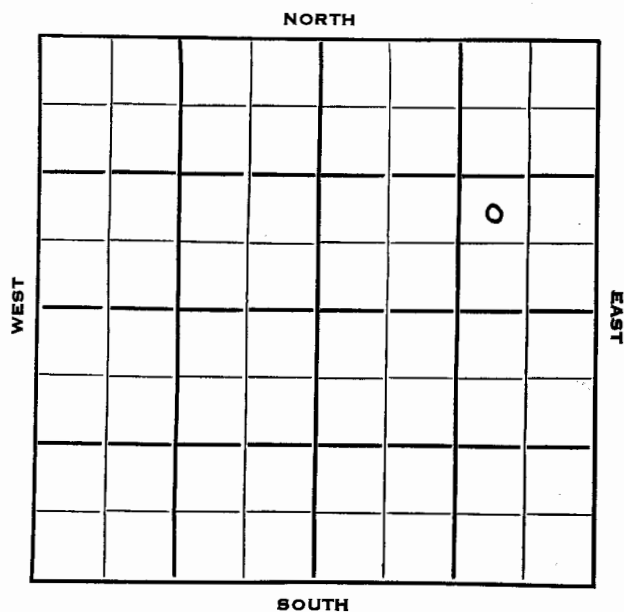


Ellis KANSAS

Section 32 Township 12 Range 17WWell No. #4 StaabCompany Sunray


Ellis KANSAS

SEC. <u>32</u>	TWP. <u>12</u>	R. <u>17W</u>
----------------	----------------	---------------

WELL NO. #4 Staab FARM

COMPANY Sunray

CONTRACTOR

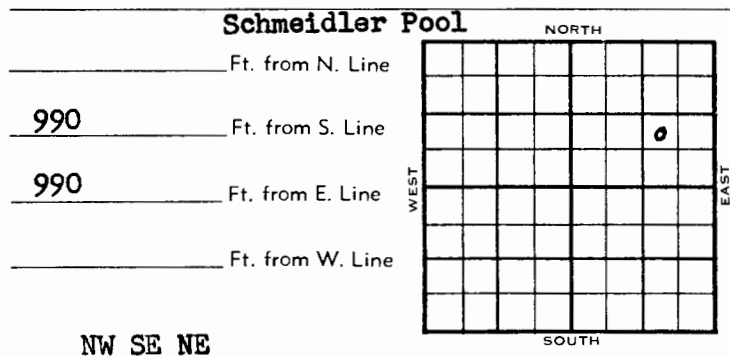

	ELEVATION	REPORT
1953	Elev. -	
9/16	Location	
9/23	"	
9/30	Abandoned Location	
	ABANDONED	

DX-78

County Ellis State Kansas
 Sec. 32 (Blk. Twp.) 12 (Sur. Rge.) 17W Map No.
 Operator Sunray Oil
 Well No. 4 Farm Staab

Elev. _____ Location NW SE NE
 990 Ft. From S Line NE
 990 Ft. From E Line Quarter
 1st. Report _____
 Completion SEP 30 1953
 Remarks _____
 Spudding Date _____

Drig. Data _____
 Abd. location _____

J. G. McGEHEE

County Ellis State Kansas
 Sec. 32 (Blk. Twp.) 12 (Sur. Rge.) 17W Map No.
 Operator Sunray
 Well No. 4 Farm Staab

Elev. _____ Location NW SE NE
 990 Ft. From S Line NE
 990 Ft. From E Line Quarter
 1st. Report SEP 16 1953
 Completion _____
 Remarks _____
 Spudding Date _____

Drig. Data _____
 Location Schmeidler Pool

J. G. McGEHEE