


Section 32 Township 12 Range 17WWell No. 1 NussCompany Jones & Shelborne

Smidler

NORTH

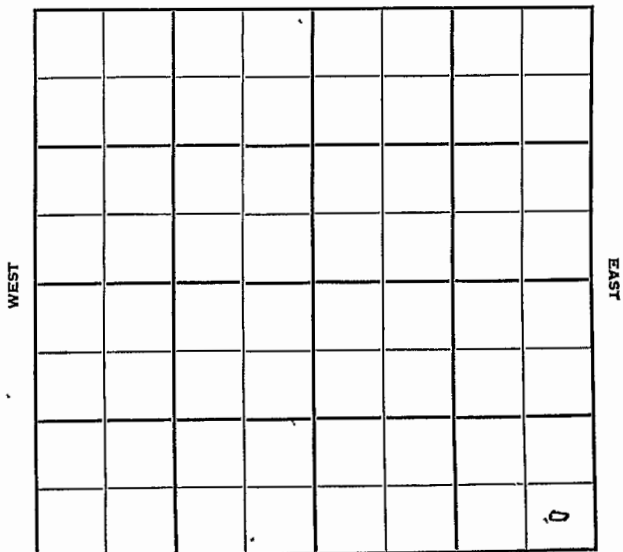

SOUTH

Sec. 32 Twp. 12 R. 17WWell No. 1 Nuss FarmJones & Shelborne Company

Smidler Pool


NORTH

_____ Ft. from N. Line

330 Ft. from S. Line330 Ft. from E. Line

_____ Ft. from W. Line

SE/C

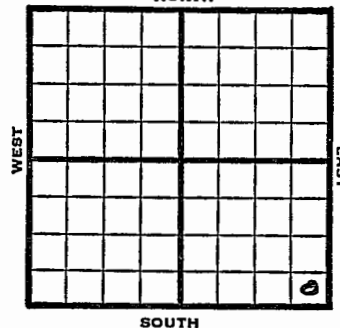

SOUTH

1949

Elev 2083' REPORT

9/28

Loc.

10/5

8" @ 196'

Drlg 2915'

10/12

TD 3678-In Cong.

Lans 3365'

Cong 3668'

Aband.

ABANDONED


Map No. _____ Sec. 32 Twp. 12 R. 17W

Well No. 1 Nuss

Jones & Shelborne Company

SE/C

Contractor

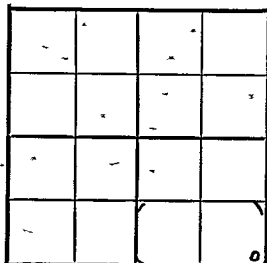FIRST REPORT
SECTION PLAT

Ft. from N. Line

330 Ft. from S. Line

330 Ft. from E. Line

Ft. from W. Line

Ellis County

Location X

RECORD

Cased in. ft.

Sand

Gas

Oil

Total Depth

PRODUCTION

1st 24 hrs. Nat.

1st 24 hrs. after shot

Gas Cu. Ft.

Dry Hole

Abandoned

Date

SEP 28 1949 19

S. J. LEWIS Scout

Map No. _____ Sec. 32 Twp. 12 R. 17W


Well No. 1 Nuss

Jones & Shelborne Company

ABANDONED

Contractor

SE/C

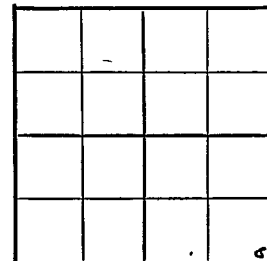E1203
SECTION PLAT

Ft. from N. Line

330 Ft. from S. Line

330 Ft. from E. Line

Ft. from W. Line

Ellis County

Location

RECORD

Cased in. ft.

Sand

Gas

Oil

Total Depth 2625 ft. in. 2625

PRODUCTION

1st 24 hrs. Nat.

1st 24 hrs. after shot

Gas Cu. Ft.

Dry Hole

Abandoned

Date

OCT 12 1949 19

S. J. LEWIS Scout