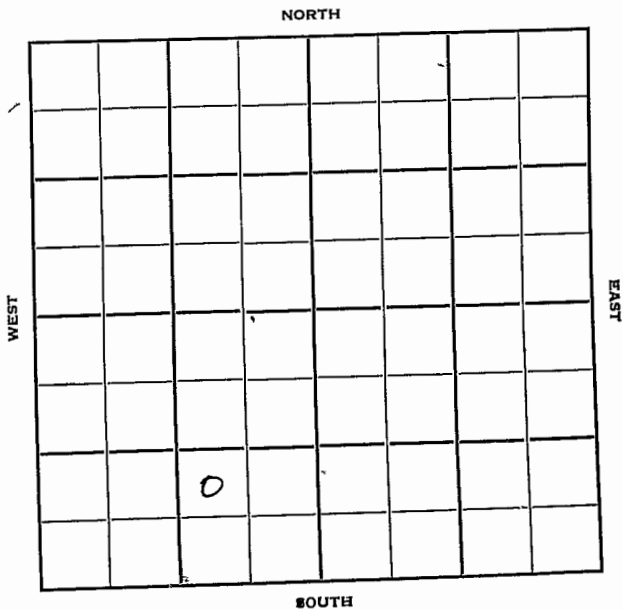


Section 33 Township 12 Range 17-WWell No. #1 SchmeidlerCompany Aurora GasSec. 33 Twp. 12 R. 17-WWell No. #1 Schmeidler Farm V

Aurora Gas Company

B & R Drlg. Contracto

Schmeidler


Ft. from N. Line

990 Ft. from S. Line

990 Ft. from E. Line

Ft. from W. Line


NW SE SW

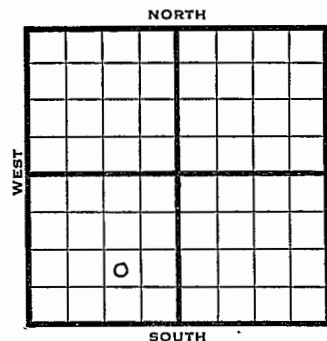

1950 Elev 2085 REPORT

7/12 Spud 7-2-50
8" @ 206
Anhy 1293
Drlg. 3090
8" @ 206
9/13 Anhy 1293 Heeb 3311
Lans 3359
DST 3408-25 op 30 min rec 30' hoom
Cong 3609 Arb 3645-67
5" @ 3587
12/3542-45 500 A B/5 boph
1500 A B/1/2 boph SP 3470
12/3545-58
DC 3465
12/3454-58 12/3452-56
500 A B/7 bwph SP 3447
12/3442-46
B/1/2 go 6 bwph 500 A B/1/2 go 25 gwph
Sp 3430 24/3411-19
500 A B/10 go 75 gwph
S/5 bo 6 gwph
TD 3311
D&A
ABANDONED

County Ellis State Kansas
 Sec. 33 (Bk. 12) (Sur. 17W) Map No. 17W
 Operator Aurora Gas
 Well No. 1 Farm Schmeidler
 Elev. 2085 Location NW SE SW

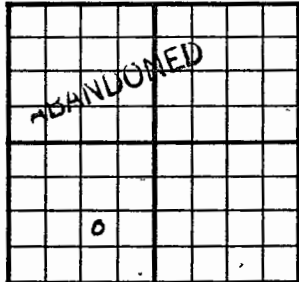

990 Ft. From S Line SW
 990 Ft. From E Line Quarter

1st. Report

Completion SEP 13 1950

Remarks

Schmeidler PoolSpudding Date 7-2-50Drlg. Data D & A TD36678" @ 206 Anhy 1293 Heeb. 3311Lans. 3359 DST 3408-25 open 30 min.Rec. 30' hocm Cong. 3609 Arb. 3654-675" @ 3587 12/ 3542-45 500 A B/ 5 goph1500 A B/ $\frac{1}{2}$ boph SP 3470 12/ 3454-58DC 3465 12/ 3454-58 12/ 3452-56500 A B/ 7 gwph SP 3447 12/ 3442-46B/ $\frac{1}{2}$ go 6 gwph 500 A B/ $\frac{1}{2}$ go 25 gwphSP 3430 24/ 3411-19 500 A B/ 16 go75 gwph S/ 5 go 6 gwphD & A

J. E. TYRA


Map No. _____ Sec. 33 Twp. 12 R. 17WWell No. 1 SchmeidlerAurora Gas

Company

B & R Drlg.

Contractor

NW SE SW

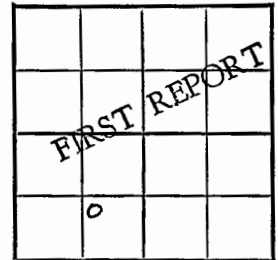E/ 2085
SECTION PLAT

Ft. from N. Line

990 Ft. from S. Line990 Ft. from E. Line

Ft. from W. Line

Ellis County

Location

Rig up

Drilling and Remarks:

Spud 7-2-508" @ 206Anhy 1293drlg. 3090

RECORD

Cased _____ in., _____ ft.

Sand

Gas

Oil

Total Depth

PRODUCTION

1st 24 hrs. Nat.

1st 24 hrs. after shot

Gas _____ Cu. Ft.

Dry Hole

Abandoned

Date

JUL 12 1950 19J. E. TYRA Scout