


KANSAS

Ellis

Section 33 Township 12 Range 17WWell No. 1 Schmeidler "A"Company Keating Drlg.

Schmeidler Pool

NORTH

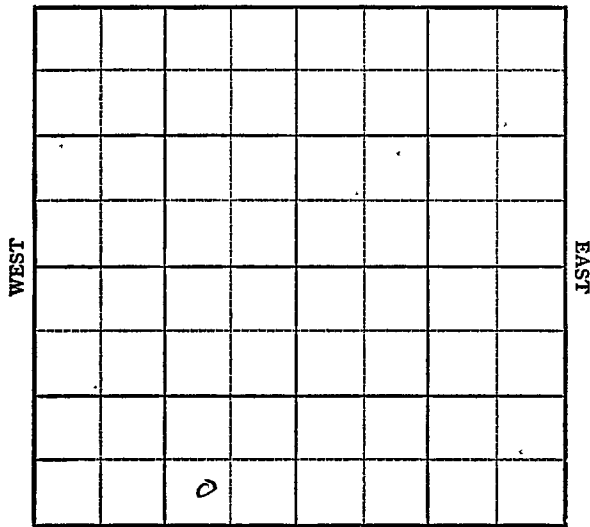

SOUTH

KANSAS

Ellis

Sec. 33Twp. 12R. 17W ✓Well No. #1 Schmeidler "A"

Farm

Keating Drlg.

Company

Schmeidler Pool

Ft. from N. Line

330'


Ft. from S. Line

990'

Ft. from E. Line

Ft. from W. Line

SW SE SW

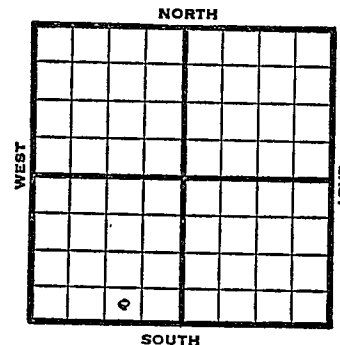

1948

Elev. 2072' REPORT

11/10 Drlg. 648'
 11/16 12" @ 980'
 Drlg. 2508'
 11/23 Drlg 3305'
 11/30 Lansing 3338'
 TD 3626' in Cong.
 5" @ 3602'
 12/8 "
 12/15 45 shots 3518-23
 3500 acid
 Swb 5 bbls oil PH 18 hrs.
 12/22 "
 12/29 "
 1/5 "
 1/12 "
 1/19 "
 1/26 Lans. 3338'
 5" @ 3602'
 Perf. Lans.
 3500 acid
 Pump 87 oil & 14% W. Pot.
 Gr. 26°
 TD 3626 in Cong.
COMPLETED

Kansas

Schmeidler Pool

Map No. 71 Sec. 33 Twp. 12 R. 17WWell No. 1 Schmeidler "A"

Keating Drlg.

Company

COMPLETE

Contractor

SW SE SW

SECTION PLAT

Ft. from N. Line

330 Ft. from S. Line

990 Ft. from E. Line

Ft. from W. Line

Ellis County

Location

Rig up

Drilling and Remarks:

Lane 3338
*5" C8602**Prof. Lane*
*Good**Pump 57006 + 1470A*
Pat 2635

RECORD

Cased in. ft.

Sand

Gas

Oil

Total Depth *2635*

PRODUCTION

1st 24 hrs. Nat.

1st 24 hrs. after shot

Gas Cu. Ft.

Dry Hole

Abandoned

Date

1AN 26 1949

19

S. J. LEWIS

Scout

Kansas

Schmeidler Pool

Map No. Sec. 33 Twp. 12 R. 17WWell No. 1 Schmeidler "A"

Keating Drlg.

Company

FIRST REPORT

Contractor

SW SE SW

SECTION PLAT

Ft. from N. Line

330 Ft. from S. Line

990 Ft. from E. Line

Ft. from W. Line

Ellis County

Location

Rig up

Drilling and Remarks:

drlg. 648

RECORD

Cased in. ft.

Sand

Gas

Oil

Total Depth

PRODUCTION

1st 24 hrs. Nat.

1st 24 hrs. after shot

Gas Cu. Ft.

Dry Hole

Abandoned

Date

NOV 10 1948 19

S. J. LEWIS

Scout