


KANSAS

SECTION 33 TOWNSHIP 12 RANGE 17W
WELL NO. #1 Staab
COMPANY Okmar

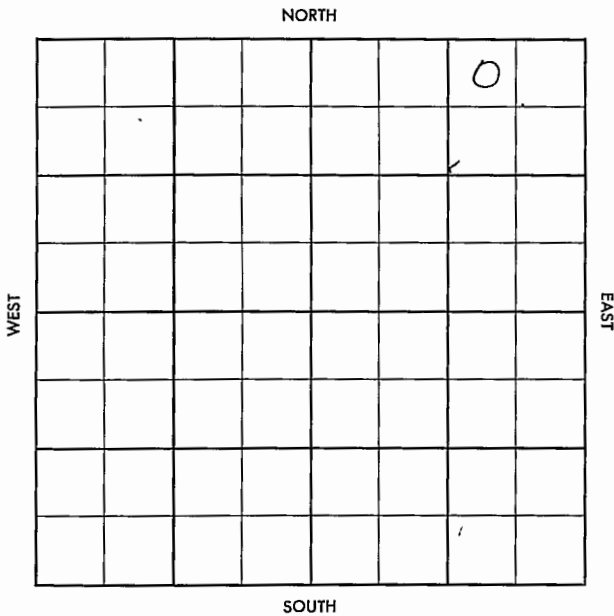

Ellis

KANSAS


SEC.	TWP.	R.
33	12	17W
WELL NO.		
#1 Staab		
COMPANY		FARM
Okmar		
CONTRACTOR		

C&G

NW Catherine

_____ Ft. from N. Line
_____ Ft. from S. Line
_____ Ft. from E. Line
_____ Ft. from W. Line

NW NE NE

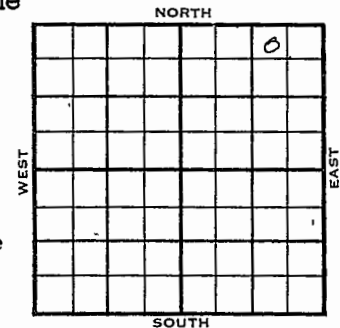

1956

ELEVATION
2112'

REPORT

5-18

Comm. 5-14-56
8" @ 179 w/135
Drlg. 185'

5-29 DST 3390-3423 op 30 min, rec. 5' mud,
~~DS~~ 125/20".
 DST 3445-68 op 30 min, rec. '8 mud,
 BHP 550/202.
 D&A
 Anh. 1328', Tp. 3095', H. 3337',
 L. 3385', C. 3638', S. 3670', A. 3678'
 TD 3687'

ABANDONED

FORM 513 SUNRAY

County Ellis Elev. 2112 Co.
 Sec. 33 Twp. 12 Rge. 17W
 Company Okmar
 FarmName Staab No. 1

TOPS	DEPTH	LOG	DATUM	Loc. in Sec.
Anh.	1328			NW NE NE
Tr.	3095			
H.	3337			
Tr.				
Dg.				
Bl.				Geol.
L.	3385		1273	
K.C.				
B.K.C.				
Ce.				
C.	3638		1526	Contr.
M.				
M.				
K.				
Mz.				
Mo.				Pool
V.				
S.	3670		1558	
S.				
A.	3678		1566	
R.				NW Catherine
Pe.				
G.				
TR.	3687			

ABANDONED

Date Comm. 5-11-56 MAY 29 1956

8" @ 179/135 drlg. 185 MAY 23 '56

3188 MAY 29 '56 DST 3390-3423

30" re 5' Md 125/20" DST

3445-68 30" re 8' Md BHP

550/20"

D&A

FORM 513 SUNRAY

County Ellis Elev. 2112 Co.
 Sec. 33 Twp. 12 Rge. 17W
 Company Okmar
 FarmName Staab No. 1

TOPS	DEPTH	LOG	DATUM	Loc. in Sec.
Anh.				NW NE NE
Tr.				
H.				
Tr.				
Dg.				
Bl.				Geol.
L.				
K.C.				
B.K.C.				
Ce.				
C.				Contr.
M.				
M.				
K.				
Mz.				
Mo.				Pool
V.				
S.				
S.				
A.				
R.				NW Catherine
Pe.				
G.				
TR.				

FIRST REPORT

MAY 16 '56

Date Comm. 5-11-56

8" @ 179/135 drlg. 185

8881 S S YAM