

Section 33 Township 12 Range 17W

Well No. #1 Staab

Company Dizard Investment

Sec. 33 Twp. 12 R. 17W

Well No. #1 Staab Farm

Dizard Investment Company

Nye Drlg. - Contr. Contractor

Catherine Pool


330' Ft. from N. Line

Ft. from S. Line


Ft. from E. Line

330' Ft. from W. Line

NW NW NW

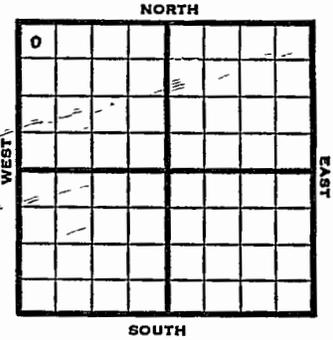

NORTH

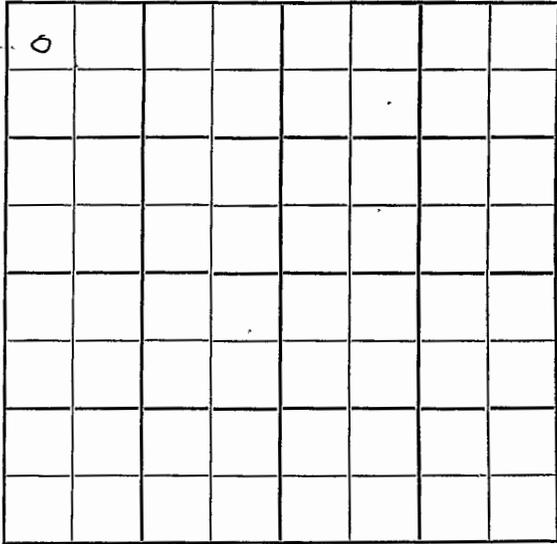

SOUTH

1951 Elev. 2142' REPORT

8/29 Spud 8-24-51
8" @ 101
Anhy 1352
Drlg. 2056'

11/11 Spud 8-24-51
Oil well TD 3685' 8" @ 101'
Anhy 1352' Heeb 3359' Dodge 3391'
Lans. 3410' Simp. 3665' Arb 3683'
5" @ 3684' TD 3685' 500 A
S/2 1/2 BOPH 1500 A S/5 BOPH
P/24 BO 6 hr.
Comp. 100 BOPD

COMPLETED

County Ellis State Kansas

Sec. 33 (Blk. Twp.) 12 (Sur. Rge.) 17W Map No.

Operator Dizdar Investment

Well No. 1 Farm Staab

Elev. Location NW NW NW

o					

330 Ft. From N Line NW

330 Ft. From W Line Quarter

Ist. Report AUG 29 1951

Completion

Remarks Sunray III

Nye Drlg. - Contr.

Spudding Date 8-24-51

Drlg. Data Catherine Pool

8" @ 101 Anhy 1352 drlg. 2056

J. E. TYRA

County Ellis State Kansas

Sec. 33 (Blk. Twp.) 12 (Sur. Rge.) 17W Map No.

Operator Dizdar Investment

Well No. 1 Farm Staab

Elev. 2142 Location NW NW NW

o					

330 Ft. From N Line NW

330 Ft. From W Line Quarter

Ist. Report

Completion NOV 14 1951

Remarks Catherine Pool

Nye Drlg. - Contr.

Spudding Date 8-24-51

Drlg. Data Oil well. TD 3685

8" @ 101 Anhy 1352 Heeb. 3359

KC-3410 Dodge 3391 Lans. 3410

Simp. 3665 Arb. 3683 5" @ 3684

TD 3685 500 A S/ 2 1/2 boph 1500 A

S/ 5 boph P/ 24 bo 6 hr.

Comp. 100 bopd

J. E. TYRA