


Ellis KANSAS

SECTION 33 TOWNSHIP 12 RANGE 17W

WELL NO. #1 Staab

COMPANY Brunson Drlg. Apache Oil

NORTH NE SW NW

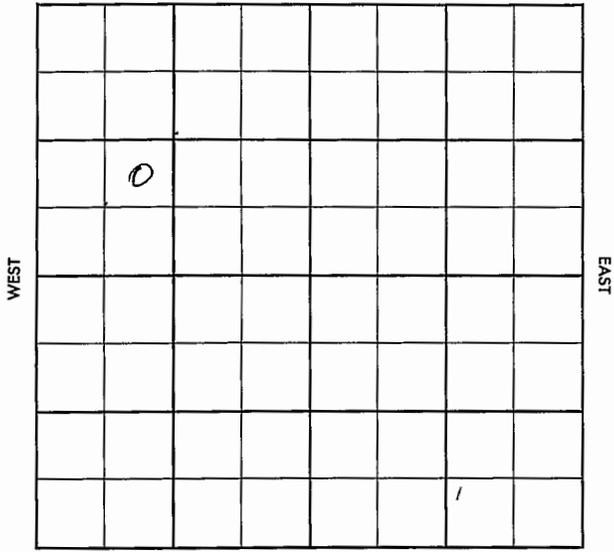

SOUTH

Ellis KANSAS

SEC. 33 TWP. 12 S R. 17 W

WELL NO. # 1 Staab

COMPANY Apache Oil Brunson Drlg.


CONTRACTOR Co. tools Schmeidler

_____ FT. FROM N. LINE

_____ FT. FROM S. LINE

_____ FT. FROM E. LINE

_____ FT. FROM W. LINE

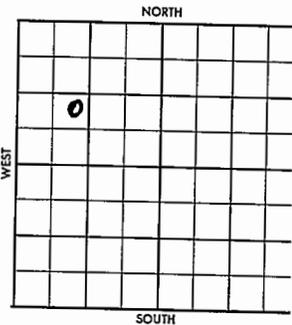

NE SW NW SDX-1/4 Mile

1957 ELEVATION REPORT

2/6 Spud 2-4-57 8" @ 211/130 WOC (FR Tkt)

FORM 513 SUNRAY

CORRECTION

County Ellis Elev. 2117 DP
 Sec. 33 Twp. 13 Rgs. 17W
 Company Brunson Drilling Apache oil
Staab No. 1

	DEPTH	LOG	DATUM	Loc. in Sec.
	<u>1735</u>			<u>NE SW NW</u>
H.	<u>3352</u>			
Tr.	<u>3375</u>			
Dg.				
Bl.				
L.	<u>3400</u>			
K.C.				Geol.
B.K.C.				Contr.
Ce.				<u>Co. tools</u>
C.	<u>3650</u>			
M.				Pool
M.				<u>Schmeidler</u>
K.				
Mz.				
Mo.				
V.				
S.				
S.				
A.				
R.				
Pe.				
G.				
T.D.	<u>3809</u>			

Date Comm. 2-1-57
8" @ 211/130 WOC FEB 13 57 03662
FEB 20 57

DEW

FORM 513 SUNRAY

County Ellis Elev. _____
 Sec. 33 Twp. 13 Rgs. 17W
 Company Brunson Drilling
 Farm Name Staab No. 1

	TOPS	DEPTH	LOG	DATUM	Loc. in Sec.
Anb.					<u>NE SW NW</u>
Tr.					
H.					
Tr.					
Dg.					
Bl.					
L.					Geol.
K.C.					Contr.
B.K.C.					<u>Co. tools</u>
Ce.					
C.					Pool
M.					<u>Schmeidler</u>
M.					
K.					
Mz.					
Mo.					
V.					
S.					
S.					
A.					
R.					
Pe.					
G.					
T.D.					

Date Comm. 2-1-57
8" @ 211/130 WOC

FEB 6 '57
 1/4 mile
 FIRST REPORT

FEB 3 1957

WOC