


Section 33 Township 12 Range 17-W
Well No. #2 Schmeidler
Company Ashland Oil & Refg

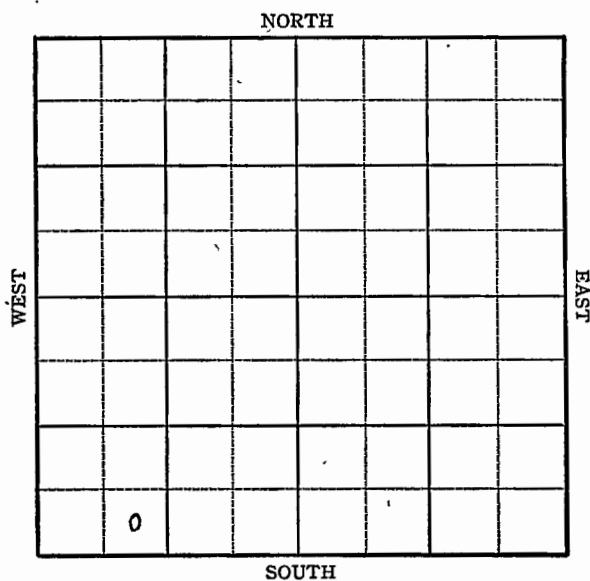

Sec. 33 Twp. 12 R. 17W
Well No. #2 Schmeidler Farm
Ashland Oil Ref. Company

Schmeidler

_____Ft. from N. Line


330
~~990~~ Ft. from S. Line

~~990~~ Ft. from S. Line

990 Ft. from E. Line

990 Ft. from W. Line

SE SW

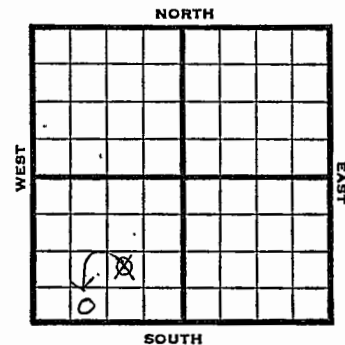~~NW~~ SE SW

1946	Elev. 2084	REPORT
------	------------	--------

3/6 RUR
3/13 Anhy 1280' 8" - 1294'
Drlg. 162 0'
3/21 Drlg. 3260'
3/28 Lans. 3345' Arb. 3615-17' T.D.
5" - 3616' RUST.

4/4	1000 acid.
	Swb. $2\frac{1}{2}$ oil per hr. 1500 acid.
	No increase

4/10 | Swb 5 oil PH; 20 hrs SW

4/16	"	"	"
------	---	---	---

4/23	"	"	"
------	---	---	---

5/1	11	11	11
-----	----	----	----

5/7	11	11	11
-----	----	----	----

5/14

5/22 Arb. 3615
5" @ 3616
2500 acid.
TD 3617'
Pump 107 oil plus 11% W. Pot.
Grav. 27.0


COMPLETED

KANSAS
 Map No. 71 Sec. 33 Twp. 12 R. 17W
 Well No. 2 Schmeidler

Ashland Oil Ref. _____ Company
COMPLETED Contractor
 SE SW SW E12084

SECTION PLAT

_____ Ft. from N. Line
330 Ft. from S. Line
 _____ Ft. from E. Line
990 Ft. from W. Line

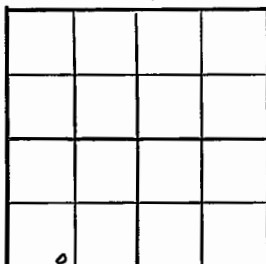

Ellis County

Location _____

Rig up _____

Drilling and Remarks:

Cor 83615
5" @ 3616
25000 acial
Pump 107 in 6 +
11 1/2 W. P. 8.
27 3/4

RECORD

Cased _____ in., _____ ft.
 Sand _____
 Gas _____
 Oil _____
 Total Depth 3617

-PRODUCTION-

1st 24 hrs. Nat. _____
 1st 24 hrs. after shot _____
 Gas _____ Cu. Ft.
 Dry Hole _____
 Abandoned _____

Date

MAY 22 1946 19 _____ S. J. LEWIS Scout


KANSAS Kansas Pool Name Schmeidler
 Map No. 7/ Sec. 33 Twp. 12 R. 17W
 Well No. 2 Schmeidler

Ashland Oil Ref. _____ Company

CORRECTION _____ Contractor

SE SW SW

SECTION PLAT

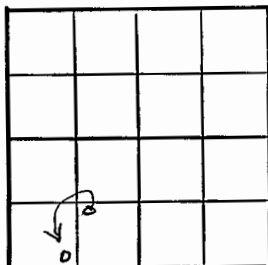

_____ Ft. from N. Line

330 Ft. from S. Line

_____ Ft. from E. Line

990 Ft. from W. Line

Ellis County

Location _____

Rig up _____

Drilling and Remarks:

Reported
NW SE SW

RECORD

Cased _____ in., _____ ft.

Sand _____

Gas _____

Oil _____

Total Depth _____

PRODUCTION

1st 24 hrs. Nat. _____

1st 24 hrs. after shot _____

Gas _____ Cu. Ft.

Dry Hole _____

Abandoned _____

Date

MAR 13 1946

19

S. J. LEWIS

Scout


KANSAS Kansas Pool Name Schmeidler
 Map No. 7/ Sec. 33 Twp. 12 R. 17W
 Well No. 2 Schmeidler

Ashland Oil Ref. _____ Company

FIRST REPORT _____ Contractor

NW SE SW

SECTION PLAT

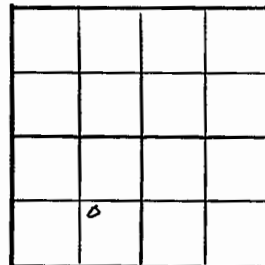

_____ Ft. from N. Line

990 Ft. from S. Line

990 Ft. from E. Line

_____ Ft. from W. Line

Ellis County

Location _____

Rig up _____

Drilling and Remarks:

RUR

RECORD

Cased _____ in., _____ ft.

Sand _____

Gas _____

Oil _____

Total Depth _____

PRODUCTION

1st 24 hrs. Nat. _____

1st 24 hrs. after shot _____

Gas _____ Cu. Ft.

Dry Hole _____

Abandoned _____

Date

MAR 6 1946

19

S. J. LEWIS

Scout