


KANSAS

Ellis County

Section 33 Township 12 Range 17WWell No. #4 SchmeidlerCompany Ashland Ref.

NORTH

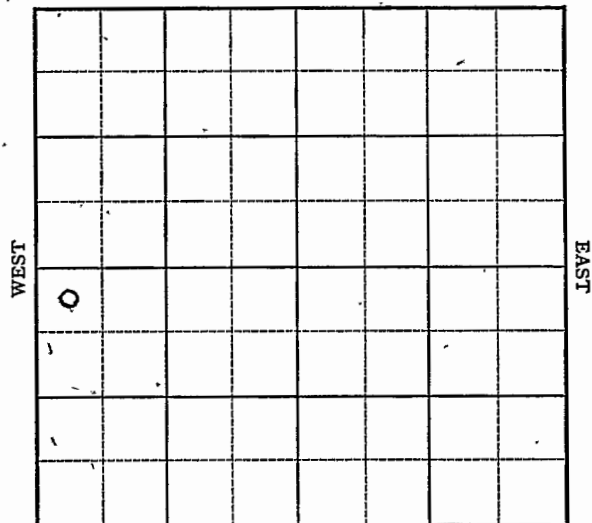

SOUTH

KANSAS

Ellis county ✓

Sec. 33 Twp. 12 R. 17WWell No. #4 Schmeidler FarmAshland Ref. Company

Schmeidler

330 Ft. from N. Line


Ft. from S. Line

Ft. from E. Line

330 Ft. from W. Line

NW SW

NORTH

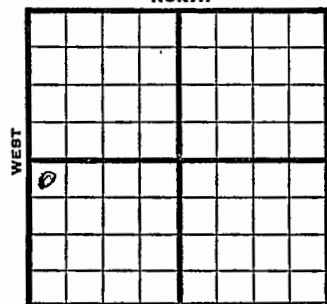

SOUTH

Elev. 2112

REPORT

1946

6/12

SH

6/18

Anhy 1312'

8" @ 1320'

Drlg 2940'

6/26

Lans 3370

Simp 3630

Arb. 3650

TD 3652'

ABANDONED

KANSAS Kansas Pool Name SchmeidlerMap No. 71 Sec. 33 Twp. 12 R. 17WWell No. 4 Schmeidler

Ashland Ref. _____ Company _____

FIRST REPORT _____ Contractor _____

NW SW

SECTION PLAT

330 Ft. from N. Line

_____ Ft. from S. Line

_____ Ft. from E. Line

330 Ft. from W. Line

ELLIS COUNTY

Location _____

Rig up _____

Drilling and Remarks:

SH

RECORD

Cased _____ in., _____ ft.

Sand _____

Gas _____

Oil _____

Total Depth _____

PRODUCTION

1st 24 hrs. Nat. _____

1st 24 hrs. after shot _____

Gas _____ Cu. Ft.

Dry Hole _____

Abandoned _____

Date

JUN 12 1946 19S. J. LEWIS ScoutKANSAS Kansas Pool Name Schmeidler PoolMap No. 71 Sec. 33 Twp. 12 R. 17WWell No. 4 Schmeidler

Ashland Ref. _____ Company _____

ABANDONED _____ Contractor _____

NW SW

SECTION PLAT

330 Ft. from N. Line

_____ Ft. from S. Line

_____ Ft. from E. Line

330 Ft. from W. Line

Ellis County

Location _____

Rig up _____

Drilling and Remarks:


RECORD

Cased _____ in., _____ ft.

Sand _____

Gas _____

Oil _____

Total Depth 3652

PRODUCTION

1st 24 hrs. Nat. _____

1st 24 hrs. after shot _____

Gas _____ Cu. Ft.

Dry Hole _____

Abandoned _____

Date

JUN 26 1946 19S. J. LEWIS Scout