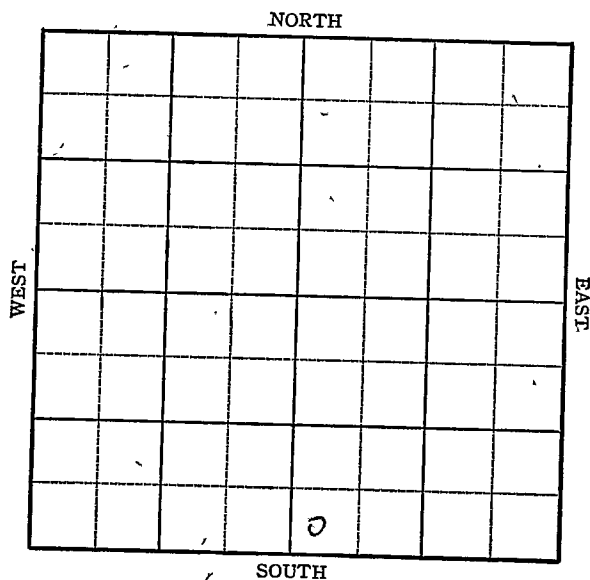


KANSAS Ellis

FORM 51 5M PETROL

Section 33 Township 12 Range 17WWell No. 1 SchmidtCompany Ashland O & Ref.FORM 252-A
5M 8-45 PETROL

KANSAS Ellis

Sec. 33 Twp. 12 R. 17WWell No. #1 Schmidt FarmAshland O & Ref. Company


Ft. from N. Line

330 Ft. from S. Line

Ft. from E. Line

330 Ft. from W. Line

SW SE. Elev. 2076

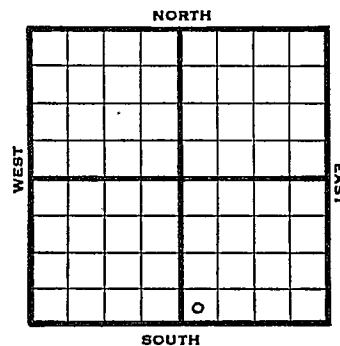

1945 REPORT

9/5 8" @ 1250'
Drlg. 1930'

9/12 Drlg. 3404'

9/19 Lans 3328
BKC 3577
Cong 3594
Arb. 3646
TD 3650'
5" @ 3600
10 shots 3512-3522
Swab 10 oil per hr.
500 acid.

9/26 Swab 10 oil per hr. 10 hrs.
1000 acid, no increase

10/3 " " " "

10/10 " " " "

10/17 Arb. 3641
5" @ 3605
Lans. 3328
Perf. Lans 1000 acid.
TD 3650
Pump 215 Pot.
Grav. 27.9

COMPLETED

KANSAS Pool Name Walters Pool
 Map No. 71 Sec. 33 Twp. 12 R. 17W
 Well No. 1 Schmidt

Ashland Oil and Ref. Company

COMPLETED

Contractor

SW SE


SECTION PLAT

Ft. from N. Line

330 Ft. from S. Line

Ft. from E. Line

330 Ft. from W. Line

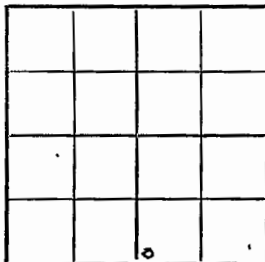

Ellis County

Location

Rig up

Drilling and Remarks:

Cr 83641

5" @ 3600

4000 325

Perf. 1000

1000 2500

27 2 1/2

RECORD

Cased in, ft.

Sand

Gas

Oil

Total Depth *2650*

PRODUCTION

1st 24 hrs. Nat.

1st 24 hrs. after shot

Gas Cu. Ft.

Dry Hole

Abandoned

Date

OCT 17 1945

19

S. J. LEWIS

Scout

KANSAS Pool Name Walters
 Map No. 71 Sec. 33 Twp. 12 R. 17W
 Well No. 1 Schmidt

Ashland O & Ref. Company

FIRST REPORT

Contractor

SW SE


SECTION PLAT

Ft. from N. Line

330 Ft. from S. Line

Ft. from E. Line

330 Ft. from W. Line

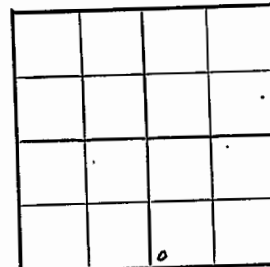

Ellis County

Location

Rig up

Drilling and Remarks:

8" - 1250

1930

RECORD

Cased in, ft.

Sand

Gas

Oil

Total Depth

PRODUCTION

1st 24 hrs. Nat.

1st 24 hrs. after shot

Gas Cu. Ft.

Dry Hole

Abandoned

Date

SEP 5 1945

19

S. J. LEWIS

Scout