


Ellis

KANSAS

SECTION 33 TOWNSHIP 12 RANGE 17W

WELL NO. #1 Schmidt "B"

COMPANY Jones, Shelburne & Farmer

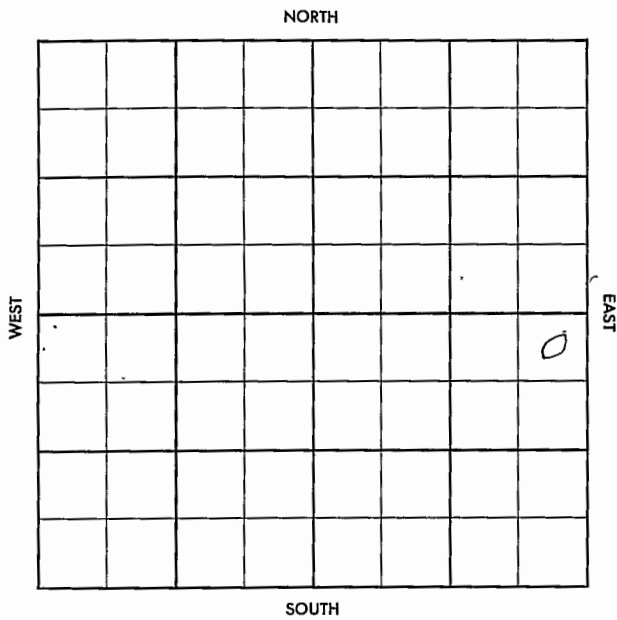

FORM 513 SUNRAY

County Ellis Elev. 2069
 Sec. 33 Twp. 12 Rge. 17W
 Company Jones, Shelburne & Farmer
 FarmName Schmidt "B" No. 1

TOPS	DEPTH	LOG	DATUM	Loc. in Sec.
Anh.	1270			NE NE SE
TP.				
H.				
Tr.				
Dg.				
BL.				
L.				
K.C.				Geol.
B.K.C.				Contr.
Ce.				Co. Tools
C.				
M.				Pool
M.				Catharine NW
K.				
Mz.				
Ma.				
V.				
S.				
S.				
A.				
R.				
Pe.				
G.				
T.D.				

DEC 28 '56

FIRST REPORT

Date Comm. 12-18-56
8" @ 160 w/110, Drlg. 3200

FORM 513 SUNRAY

County Ellis Elev. 2069
 Sec. 33 Twp. 12 Rge. 17W
 Company Jones, Shelburne & Farmer
 FarmName Schmidt "B" No. 1

TOPS	DEPTH	LOG	DATUM	Loc. in Sec.
Anh.	1270			NE NE SE
TP.				
H.	3292			
Tr.	3314			
Dg.				
BL.				
L.	3337			Geol.
K.C.	3532			Contr.
B.K.C.				Co. Tools
Ce.				
C.	3601			Pool
M.				Catharine NW
M.				
K.				
Mz.				
Ma.				
V.				
S.	3616			
S.	3619			
A.				
R.				
Pe.				
G.				
T.D.	3650			

JAN 2 '57

ABANDONED

Date Comm. 12-18-56
8" @ 160 w/110, Drlg. 3200 JAN 2 '57

DST 3621-28 or 30" nei 10'
USOCM BHP 300

D&A