


Section 34 Township 12 Range 17 W  
 Well No. # 1 Schmidt  
 Company Harms & Burt

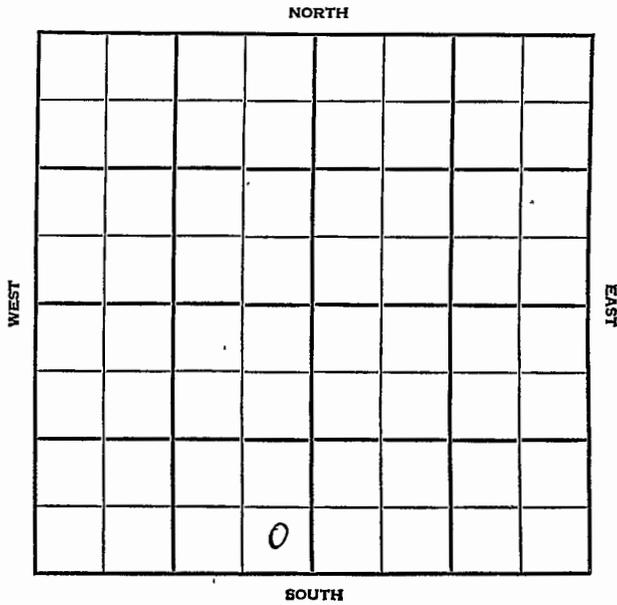

SEC. 34 TWP. 12 R. 17W  
 WELL NO. #1 Schmidt FARM  
 COMPANY Harms & Burt  
 CONTRACTOR Co Tools.

Wildcat.  
 \_\_\_\_\_ Ft. from N. Line  
330 \_\_\_\_\_ Ft. from S. Line  
330 \_\_\_\_\_ Ft. from E. Line  
 \_\_\_\_\_ Ft. from W. Line

SE SE SW

1954	ELEVATION	REPORT
	2041'	
9/15	Spud 9-10-54 8" @ 100' Anhy 1265' Drlg. 2000'	
9/29	Spud 9-10-54 D & A TD 3617' 8" @ 100' Anhy 1265', Heeb 3257', Doug 3291' Lans 3302' DST 3331'-62' opn 1 hr, rec 300' Muddy S.W. 810# DST 3397'-3437' opn 1/2 hr, rec 5' socm 30# DST 3459'-93' opn 1 hr, rec 210' gas, 55' ocm, 900# B.KC 3543' Simp 3571', Arb 3576' DST 3580'-92' opn 20 min, rec 3' Mud 25# DST 3594'-3617' opn 1 hr, rec 165' s.w 900# TD 3617' D & A	<b>ABANDONED</b>

