


Ellis

KANSAS

SECTION 34 TOWNSHIP 12 RANGE 17W

WELL NO. #1 Schmidt

COMPANY Peel Hardman

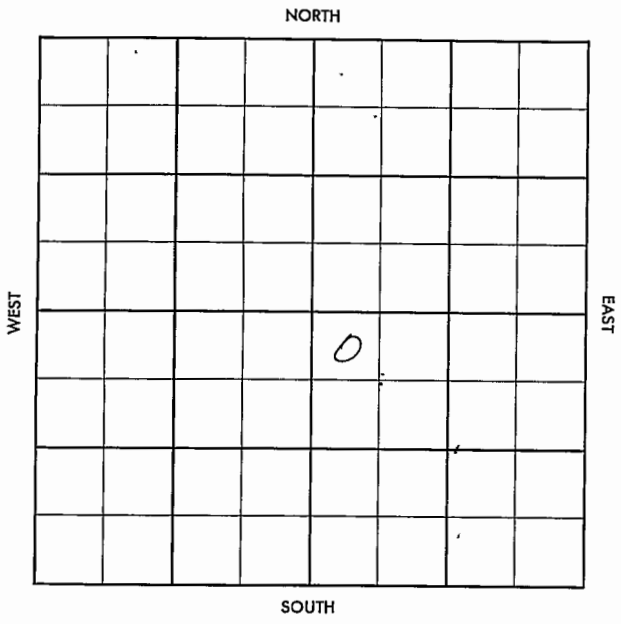

Ellis

KANSAS

SEC. 34 TWP. 12 R. 17W

WELL NO. #1 Schmidt FARM

COMPANY Peel Hardman

CONTRACTOR Peel Bros.

NW Catherine Ext. NORTH


\_\_\_\_\_ Ft. from N. Line

\_\_\_\_\_ Ft. from S. Line

\_\_\_\_\_ Ft. from E. Line

\_\_\_\_\_ Ft. from W. Line

NW NW SE

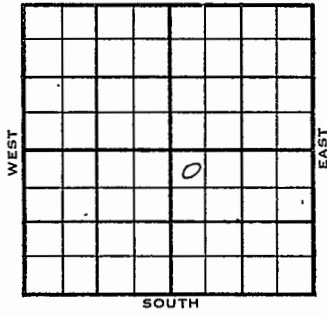

1956	ELEVATION	REPORT
	2050'	

5-16 Comm. 5-12-56  
8" @ 160  
Drlg. 1750

5-23 D&A  
Anh. 1250', H. 3271', L. 3316',  
C. Shly 3576', A. 3588',  
TD 3600'

ABANDONED

