


Ellis

KANSAS

SECTION 34 TOWNSHIP 12 RANGE 17W

WELL NO. #1 Schmidt "C"

COMPANY Sierra & Oil Trading

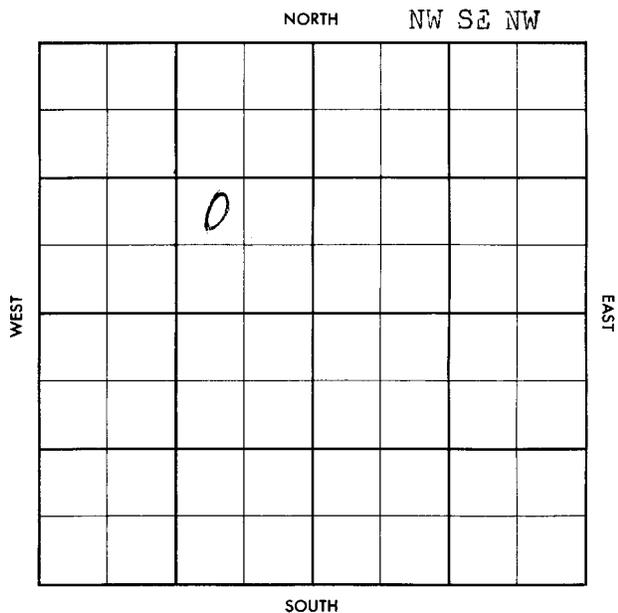

County Ellis Elev. 2062 DF
 Sec. 34 Twp. 12 Rge. 17W
 Company Sierra & Oil Trading
 Farm Name Schmidt "C" No. 1

TOPS	DEPTH	LOG	DATUM	Loc. in Sec.
Anh.				NW SE NW
TP.				
H.	3279			
Tr.	3300			
Dg.				
Bl.				
L.	3327			
K.C.				Geol.
B.K.C.				Contr.
Ce.				Sierra Drlg.
C.	3578			
M.				Pool
K.				Schmeidler SE
Mz.				
Me.				
V.				
S.	3595			
S.				
A.	3607			
R.				
PE.				
G.				
TD.	3622			

Date Comm. 6-6-57
8" @ 211/125, Drlg. 3260 JUN 19 57
DST 3343-83 1hr see 870'
SW BHP 500 DST 3384-3430
1hr see 420' HO 6' GCM + 360'
HO 6' G-8' WCM + 180' HO 6' GCW
+240' 50' 6' GCW BHP 965' 20"
DST 3410-28 1hr see 8' 50' GCM
BHP 865' 20"
DQA

County Ellis Elev. 2062 DF
 Sec. 34 Twp. 12 Rge. 17W
 Company Sierra & Oil Trading
 Farm Name Schmidt "C" No. 1

TOPS	DEPTH	LOG	DATUM	Loc. in Sec.
Anh.				NW SE NW
TP.				
H.				
Tr.				
Dg.				
Bl.				
L.				Geol.
K.C.				Contr.
B.K.C.				Sierra Drlg.
Ce.				
C.				Pool
M.				Schmeidler
K.				FIRST REPO
Mz.				
Me.				
V.				
S.				
S.				
A.				
R.				
PE.				
G.				
TD.				

Date Comm. 6-6-57
8" @ 211/125, Drlg. 3260