

Ellis


KANSAS

SECTION 34 TOWNSHIP 12 RANGE 17 W

WELL NO. #1 Schmidt "B"

COMPANY K & E Drlg. & Oil Trading

NORTH

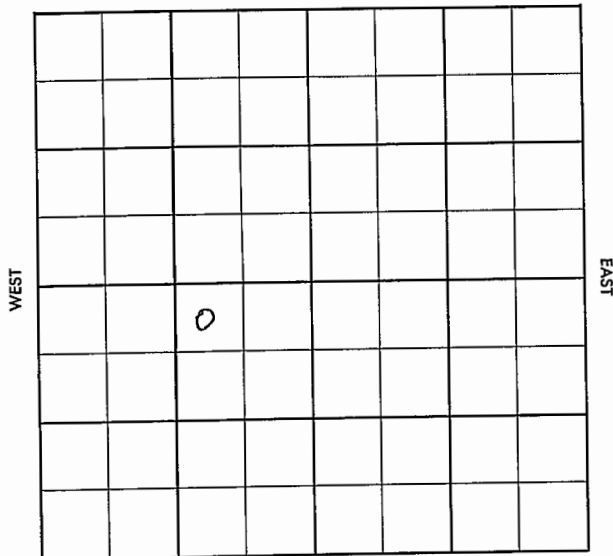

SOUTH

ELLIS KANSAS
SEC 34 TWP 12 R 17W

WELL NO

#1 Schmidt "B"

FARM

COMPANY

K&E Drlg. & Oil Trading

CONTRACTOR

K & E

SEMI-WILDCAT


_____ Ft. from N. Line

_____ Ft. from S Line

_____ Ft. from E Line

_____ Ft. from W. Line

NW NE SW

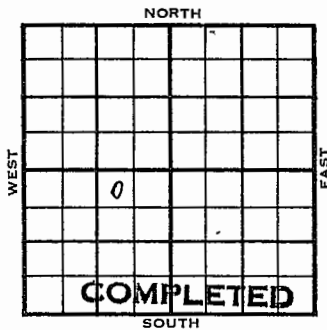

1955 ELEVATION REPORT

12-14 Comm. 12-8-55
8" @ 160/140
Drlg. 3050

DX-78

FORM 513 REV SUNRAY

County **Elas** Elev. **17W**
 Sec. **34** Twp. **12** Rge. **17W**
 Company **K & E Drig. & Oil Trading**
 FarmName **Schmidt "B"** No. **1**

TOPS	DEPTH	LOG	DATUM	Loc. in Sec
Anb.				NW NE SW
TP.				
H.				
Tr.				
Dg.				
Bl.				
L.				
K.C.				Geol.
B.K.C.				Contr.
Ce.				K & E
C.				
M.				
M.				
K.				Pool
Mz.				Semi Wildcat
Ma.				
V.				
S.				
A.				
R.				
Pe.				
G.				
T.D.				

Date Comm. **12-8-55**
8" @ 160/140 drlg. 3050

FIRST REPORT

DEC 4 55

FORM 513 REV SUNRAY

County **Elas** Elev. **17W**
 Sec. **34** Twp. **12** Rge. **17W**
 Company **K & E Drig. & Oil Trading**
 FarmName **Schmidt "B"** No. **1**

TOPS	DEPTH	LOG	DATUM	Loc. in Sec
Anb.	1240			NW NE SW
TP.	3241	3256		
H.				
Tr.				
Dg.	3307	3303	1260	Wayne L. Geol. Brinagar
Bl.	3342	3339	1494	Contr. K & E
L.				Schmidlen's Pool d. 129.
K.C.				Semi Wildcat
B.K.C.				
Ce.				
C.				
M.				
M.				
K.				
Mz.				
Ma.				
V.				
S.				
A.				
R.				
Pe.				
G.				
T.D.				

Date Comm. **12-8-55** MAR 7 1956**8" @ 160/140** drlg. 3050 DEC 21 55

DST 3324-60 **SM Gsy oil + 20' VMA 24 oil + 110'**
VHOCM BHP 925/20 DST 3455-95
OR 30" REC 10' WMA (3005 oil) BHP
0 BKG 3542 Arb 3548 DST 3566
-75 OR 30" REC 10' Md BHP 0 (Gd
Stain in Arb) RTD 3577 Log = TOPS
SL2 @ 3520/125 M147 MAR 28 55

CO 3577 TD no show DD
3583 TD Rainbow show 1/2
\$ 24 7 1/2 Boph 3 hrs 1290
with P&P JAN 5 '56 Y JAN 11 '56 wd POT
JAN 18 '56 V Dec 10 3 1/2 B.F.P.H.
5870 with JAN 25 '56 V FEB 1 '56 V FEB 8 '56
V Rework Lsg. Ks. Prod FEB 15 '56 V
DD 3599 TD \$ 16 B.W.P.H.
no/T PB : 3400 16/3330-34
\$ 13350-52 200 acid 1st set
\$ 10 1/2 130 no/w 1 1/2 hrs 300
acid Lower set \$ Both 7ns
\$ 15 Boph no/w P&P FEB 22 '56
FEB 20 '56 W&POT MAR 7 '56 Ph P. 200
Bopd no/w to grow 33°

R. G.

MAR 19 1956