

FORM 51


Ellis

KANSAS

Section 17 Township 12 Range 17W

Well No. #2 Miller

Company Isern Drlgo

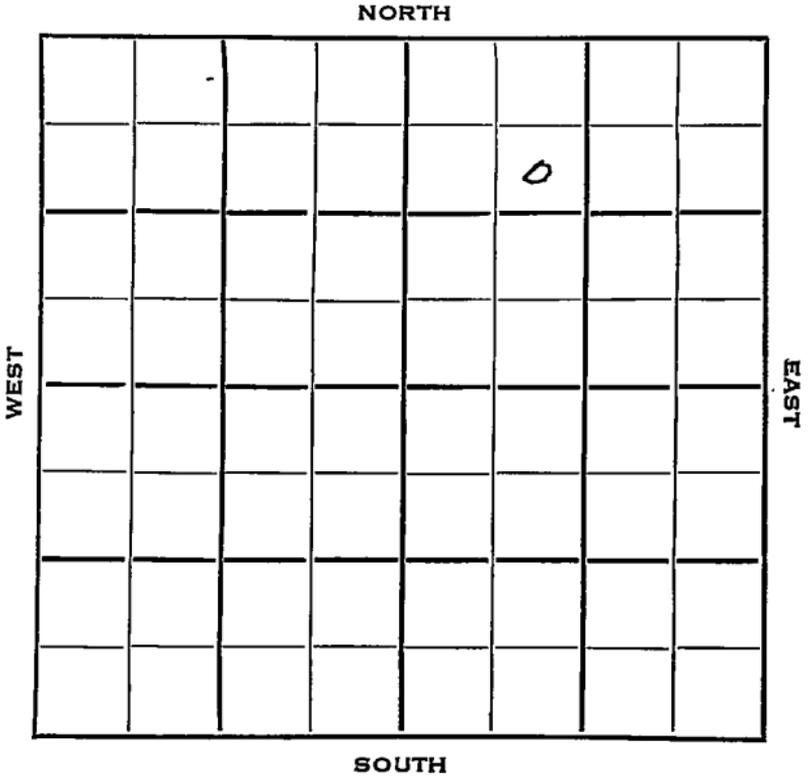

Sec. 17 Twp. 12 R. 17 W

Well No. # 2 Miller Farm

Isern Drlg. Company

Isern Drlg. Contractor


990 Ft. from N. Line

_____ Ft. from S. Line

_____ Ft. from E. Line

990 Ft. from W. Line

SE NW NE

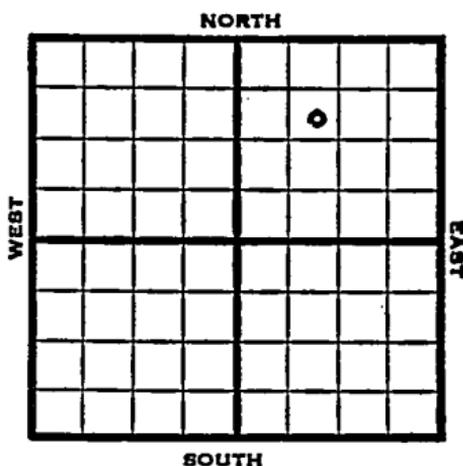

1953

Elev. 2160' REPORT

2/25

RUR

3/11

Spud 2-25-53 D & A TD 3740
 8" @ 192 Heeb 3384 Lans 3430
 Cong 3685
 DST 3688-3705 open 3/4 hr. rec 6'
 mud. TD 3740
 D & A

ABANDONED

