


Section **17** Township **12** Range **17W**

Well No. **#1 Miller**

Company **B & R Drlg.**

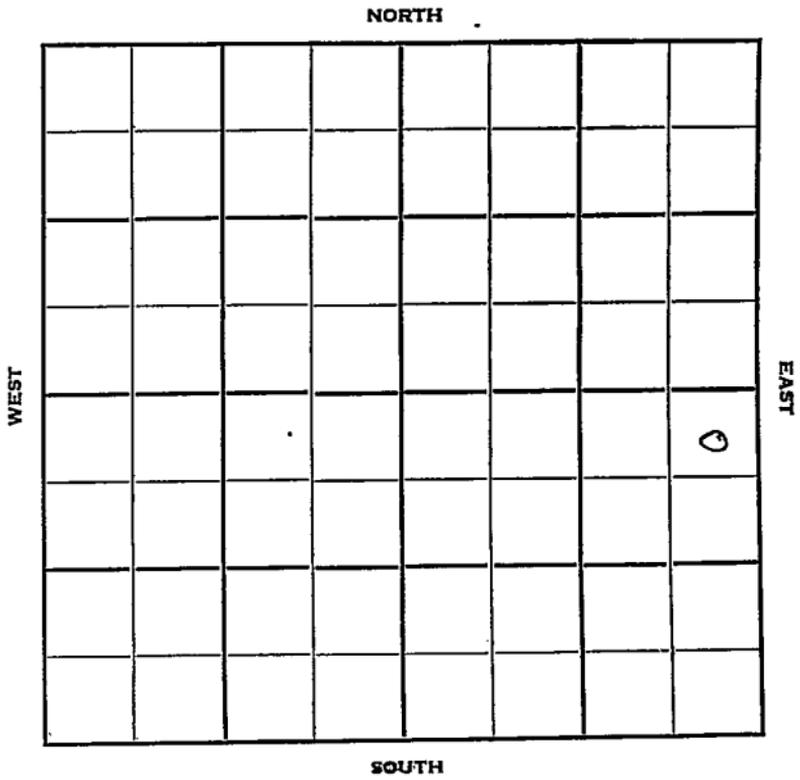

Sec. 17 Twp. 12 R. 17W

Well No. #1 Miller Farm

B & R Drlg. Company

B & R Drlg. Contractor

Wildcat


330 Ft. from N. Line

Ft. from S. Line

330 Ft. from E. Line

Ft. from W. Line

NE NE SE

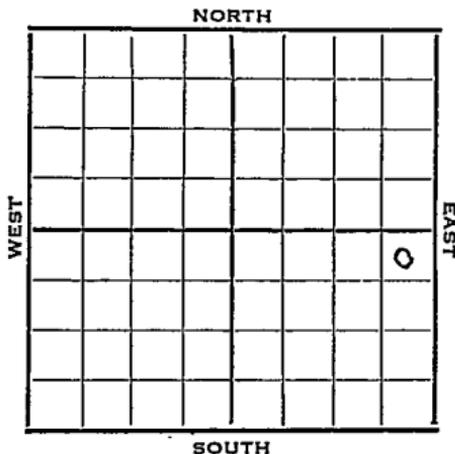

1952 Elev. 2159' REPORT

8/20 Spud 8-17-52
8" @ 213'

8/27 Anhy 1390 Drlg. 3302'

9/4 Spud 8-17-52
D&A TD 3825 8" @ 213'
Anhy 1390 Heeb. 3391
Lans. 3438 B KC 3671
Cong. 3686 Arb. 3775'
TD 3825' D&A

ABANDONED

County Ellis State Kansas

Sec. 17 (Blk. Twp.) 12 (Sur. Rge.) 17W Map No.

Operator B & R Drig.

Well No. 1 Farm Miller

Elev. _____ Location NE NE SE

FIRST REPORT

330 Ft. From N Line SE

330 Ft. From E Line Quarter

1st. Report AUG 20 1952

Completion _____

Remarks _____

B & R Drig. - Contr.

Spudding Date 8-17-52

Drig. Data Wildcat

8th © 213

J. G. McGEHEE

County Ellis State Kansas

Sec. 17 (Blk. 12 (Sur. 17W Map No. (Twp.) (Rge.))

Operator B & R Drlg.

Well No. 1 Farm Miller

Elev. 2159 Location NE NE SE

ABANDONED

330 Ft. From N Line SE

330 Ft. From E Line Quarter

Ist. Report

Completion SEP 4 1952

Remarks Wildcat

- B & R Drlg. - Contr.

Spudding Date 8-17-52

Drlg. Data D & A TD 3825

8" @ 213 Anhy 1390 Heeb. 3391

Lans. 3438 B KC 3671 Cong. 3686

Arb. 3775 TD 3825

D & A