


Section 17 Township 12 Range 17-W

Well No. #1 Miller

Company Isern Bros

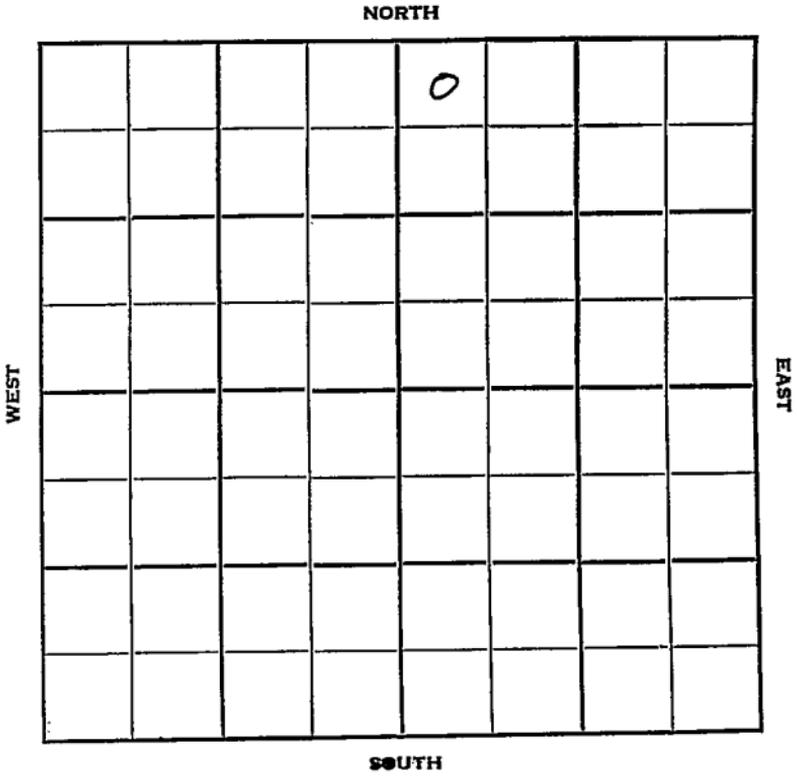

Sec. 17 Twp. 12 R. 17W ✓

Well No. #1 Miller Farm

Isern Bros. Company

Keyes Drlg. Contractor

Pleasant Ridge Pool


330' Ft. from N. Line

_____ Ft. from S. Line

_____ Ft. from E. Line

330' Ft. from W. Line

NW NW NE

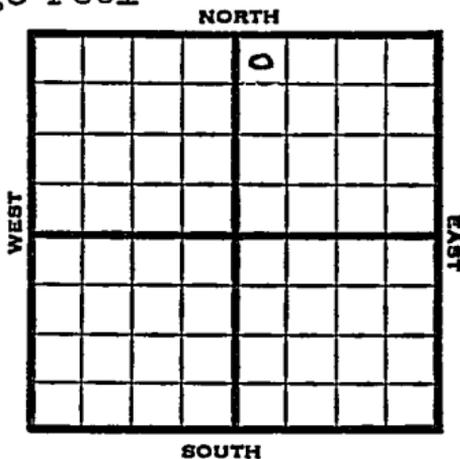

1951

Elev. 2151

REPORT

1/10

Spud 1-5-51
8" @ 190
Anhy 1365-95
Drlg. 2560'

2/21

Spud 1-5-51
Oil well TD 3682
8" @190
Anhy 1365-95 Top. 3128 Heeb. 3362
Lans. 3409 B KC 3642 Cong. 3654
Simp. 3661 sand 3677 Arb. 3681-82
5" @3677 TD 3683
S/ 1½ boph 1000 A S/ 21 boph
Comp. 263 bopd

COMPLETED


County Ellis State Kansas

Sec. 17 (Blk. Twp.) 12 (Sur. Rge.) 17W Map No.

Operator Isern Bros.

Well No. 1 Farm Miller

Elev. _____ Location NW NW NE

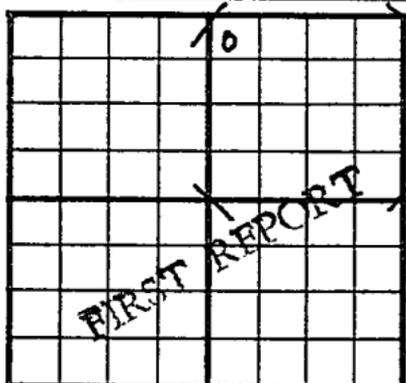

330 Ft. From N Line NE

330 Ft. From W Line Quarter

1st Report JAN 10 1951

Completion _____

Remarks _____

Spudding Date 1-5-51

Drlg. Data Pleasant Ridge Pool

8" @ 190 Anhy 1365-95 drlg. 2560

County Ellis State Kansas

Sec. 17 (Blk. Twp.) 12 (Sur. Rge.) 17W Map No.

Operator Isern Bros.

Well No. 1 Farm Miller

Elev. 2151 Location NW NW NE

		10		

330 Ft. From N Line NE

330 Ft. From W Line Quarter

1st. Report

Completion FEB 21 1951

Remarks Pleasant Ridge Pool

Keyes Drlg. - Contr.

Spudding Date 1-5-51

Drlg. Data Oil well TD 3682

8" @ 190 Anhy 1365-95 Top. 3128

Heeb. 3362 Lans. 3409 B KC 3642

Cong. 3654 Simp. 3661 sand 3677

Arb. 3681-82 5" @ 3677 TD 3683

S/ 1 1/2 boph 1000 A S/ 21 boph

Comp. 263 bopd