


Section 17 Township 12 Range 17W

Well No. #3 Schmeidler

Company G. W. Keyes

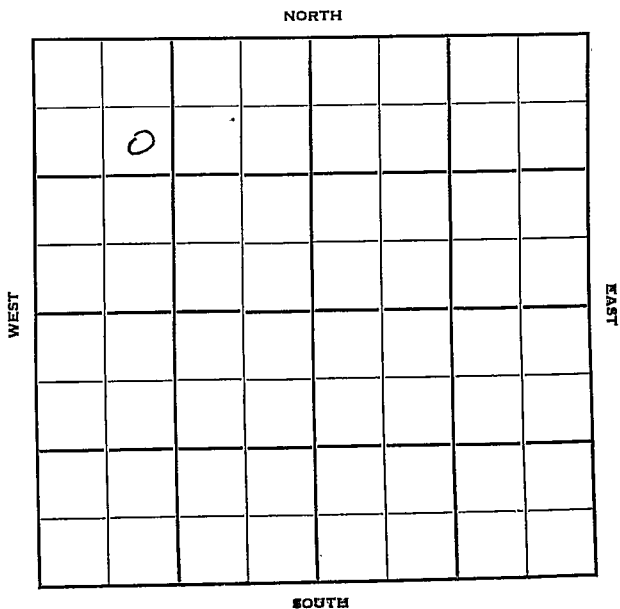

Sec. 17 Twp. 12 R. 17-W

Well No. #3 Schmeidler Farm

G W Keyes Company

Keyes Drlg. Contractor

Schmeidler


990 Ft. from N. Line

_____ Ft. from S. Line

_____ Ft. from E. Line

990 Ft. from W. Line

SE NW NW

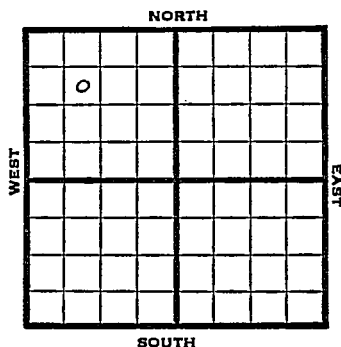

1950 Elev 2175 REPORT

9/27 Spud 9-20-50
8" @ 175
Anhy 1393-1420
drlg 3005

10/25 8" @ 175
Anhy 1393-1420 Top 3143
Heeb 3379
DST 3401-06 opn 1/2 hr rec 30' socm
Lans 3426
DST 3501-08 opn 45 min rec 15' mud
Cong 3686 Sand 3707
Arb 3710-11
5" @ 3707
TD 3714
2000 A
S/4 1/2 bo 16 hr
Comp 182 bopd
Completed

COMPLETED

