


Section 17 Township 12 Range 17 W

Well No. # 4 Schmeidler

Company Isern Bros

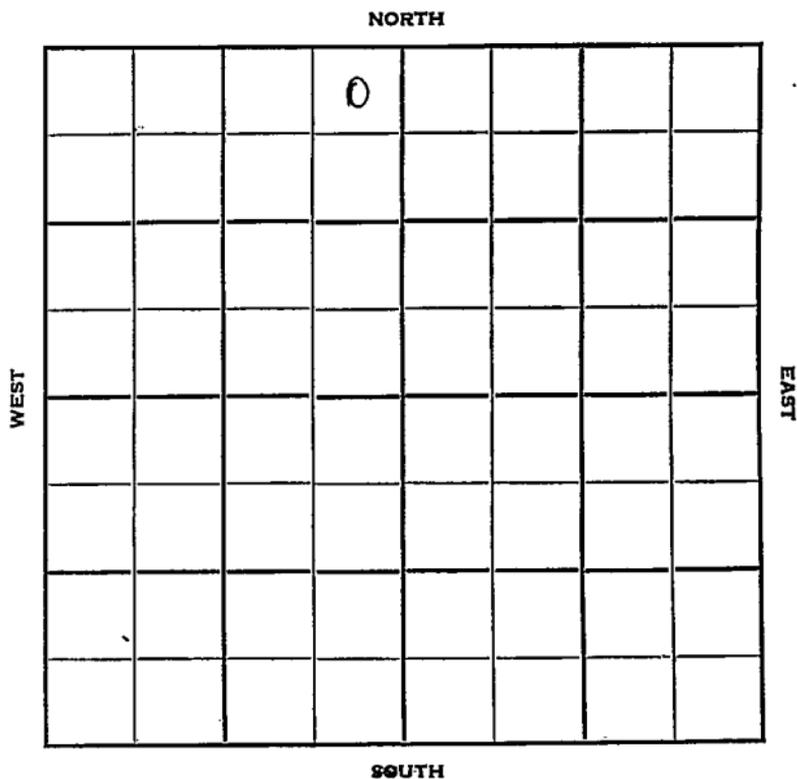

Ellis

KANSAS

Sec. 17 Twp. 12 R. 17W

Well No. #4 Schmeidler Farm

Isern Bros. Company

Contractor

Pleasant Ridge Pool


330' Ft. from N. Line

\_\_\_\_\_ Ft. from S. Line

330' Ft. from E. Line

\_\_\_\_\_ Ft. from W. Line

NE NE NW

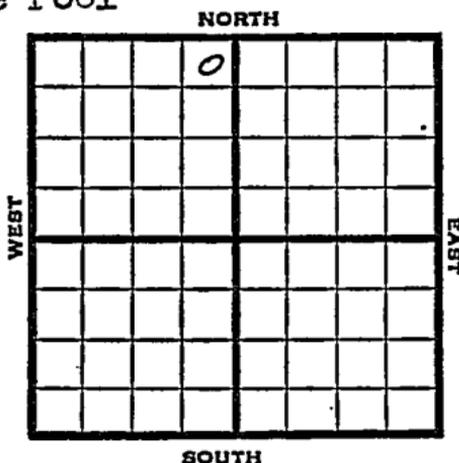

1951 Elev. 2136' REPORT

7/11

8" @ 170'  
Anhy 1368  
Drlg. 2863'

10/10

SWD Well TD 4138  
8" @ 170'  
Anhy 1368 Top. 3110  
Heeb. 3351 Lans. 3398  
Cong. 3650 Arb. 3870  
TD 4138 5" @ 3897 4000 A  
Comp. for SWD well

**ABANDONED**

County **Ellis** State **Kansas**

Sec. **17** (Blk. Twp.) **12** (Sur. Rge.) **17W** Map No.

Operator **Isern Bros.**

Well No. **4** Farm **Schmeidler**

Elev. **2136** Location **NE NE NW**

		0			

**330** Ft. From **N** Line **NW**

**330** Ft. From **E** Line **Quarter**

1st. Report **JUL 11 1951**

Completion

Remarks

Spudding Date

Drlg. Data **Pleasant Ridge - pool**

**8" @ 170' Any 1368 Drlg. 2863**

**J. E. TYRA**

County Ellis State Kansas

Sec. 17 (Blk. 12) (Sur. 17W) (Twp. 12) (Rge. 17W) Map No.

Operator Isern Bros.

Well No. 4 Farm Schmeidler

Elev. 2136 Location NE NE NW

		0			

330 Ft. From N Line NW

330 Ft. From E Line Quarter

Ist. Report

Completion OCT 10 1951

Remarks Pleasant Ridge Pool

Spudding Date

Drlg. Data SWD well TD 4138

8" @ 170 Any 1368 Top. 3110

Heeb. 3351 Lans. 3398 Cong. 3650

Arb. 3870 TD 4138 5" @ 3897 4000 A

Comp. for SWD well