

Incl

STATE CORPORATION COMMISSION OF KANSAS
OIL & GAS CONSERVATION DIVISION
WELL COMPLETION OR RECOMPLETION FORM
ACO-1 WELL HISTORY
DESCRIPTION OF WELL AND LEASE

Operator: License # 5058
Name Griggs Oil, Inc.
Address 105 N. Market, Suite 800
City/State/Zip Wichita, KS 67202

Purchaser

Operator Contact Person Wilber Berg
Phone 316-267-7779

Contractor: License # 9087
Name R & C Drilling Co., Inc.

Wellsite Geologist Rick Griggs
Phone

Designate Type of Completion

New Well Re-Entry Workover
 Oil SWD Temp Abd
 Gas Inj Delayed Comp.
 Dry Other (Core, Water Supply etc.)

If **OWNO**: old well info as follows:
Operator
Well Name
Comp. Date Old Total Depth

WELL HISTORY

Drilling Method:
 Mud Rotary Air Rotary Cable

9-21-86 9-27-86 9-27-86
Spud Date Date Reached TD Completion Date

3676
Total Depth PBTD

Amount of Surface Pipe Set and Cemented at 200 feet
Multiple Stage Cementing Collar Used? Yes No
If yes, show depth set feet
If alternate 2 completion, cement circulated from feet depth to w/ SX cmt
Cement Company Name
Invoice #

API NO. 15-051-24-430

County Ellis

CS/2 NE SE Sec. 2 Twp. 12 Rge. 18 East
X West

1650 Ft North from Southeast Corner of Section
660 Ft West from Southeast Corner of Section

(Note: Locate well in section plat below)


Lease Name Walters Well # 2

Field Name Bemis-Shutts

Producing Formation

Elevation: Ground 2106 KB 2111

Section Plat

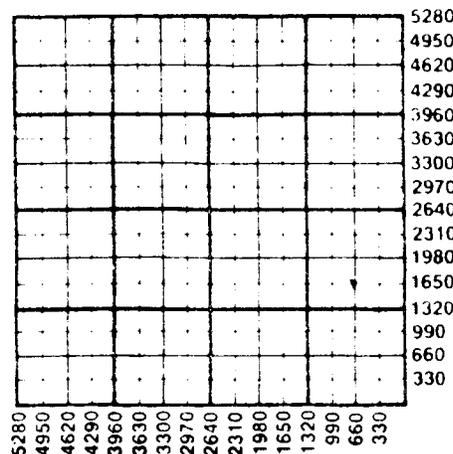

WATER SUPPLY INFORMATION

Disposition of Produced Water: Disposal
Docket # Repressuring

Questions on this portion of the ACO-1 call:
Water Resources Board (913) 296-3717

Source of Water: Water well, Ward Newcomb-Hays, KS
Division of Water Resources Permit #

Groundwater Ft North from Southeast Corner
(Well) Ft West from Southeast Corner of
Sec Twp Rge East West

Surface Water Ft North from Southeast Corner
(Stream, pond etc) Ft West from Southeast Corner
Sec Twp Rge East West

Other (explain)
(purchased from city, R.W.D. #)

INSTRUCTIONS: This form shall be completed in triplicate and filed with the Kansas Corporation Commission, 200 Colorado Derby Building, Wichita, Kansas 67202, within 120 days of the spud date of any well. Rule 82-3-130, 82-3-107 and 82-3-106 apply.

Information on side two of this form will be held confidential for a period of 12 months if requested in writing and submitted with the form. See rule 82-3-107 for confidentiality in excess of 12 months.

One copy of all wireline logs and drillers time log shall be attached with this form. Submit CP-4 form with all plugged wells. Submit CP-111 form with all temporarily abandoned wells.

SIDE TWO

Operator Name Griggs Oil, Inc. Lease Name Walters Well # 2

Sec. 2 Twp. 12 Rge. 18 East West County Ellis

WELL LOG

INSTRUCTIONS: Show important tops and base of formations penetrated. Detail all cores. Report all drill stem tests giving interval tested, time tool open and closed, flowing and shut-in pressures, whether shut-in pressure reached static level, hydrostatic pressures, bottom hole temperature, fluid recovery, and flow rates if gas to surface during test. Attach extra sheet if more space is needed. Attach copy of log.

Drill Stem Tests Taken Yes No
 Samples Sent to Geological Survey Yes No
 Cores Taken Yes No

Formation Description
 Log Sample

DST #1 3424-3472, 30-30-30-30
 ISIP 713 IFP 56-56
 FSIP 601 FFP 68-56
 HYD 1808-1808
 Recovery: 30' Mud

Name	Top	Bottom
ANHYDRITE	1394	
B. ANHYDRITE	1408	
TOPEKA	3087	
HEEBNER	3319	
TORONTO	3337	
LANSING	3366	
B. KANSAS CITY	3599	
CONGLOMERATE	3612	
ARBUCKLE	3662	

CASING RECORD New Used
 Report all strings set-conductor, surface, intermediate, production, etc.

Purpose of String	Size Hole Drilled	Size Casing Set (in O.D.)	Weight Lbs/Ft.	Setting Depth	Type of Cement	#Sacks Used	Type and Percent Additives
Surface	12 1/4	8 5/8	20 L.S.	200	60/40 pdz.	145	2% gel 3% cc.

PERFORATION RECORD		Acid, Fracture, Shot, Cement Squeeze Record	
Shots Per Foot	Specify Footage of Each Interval Perforated	(Amount and Kind of Material Used)	Depth

TUBING RECORD Size Set At Packer at Liner Run Yes No

Date of First Production Producing Method
 Flowing Pumping Gas Lift Other (explain).....