
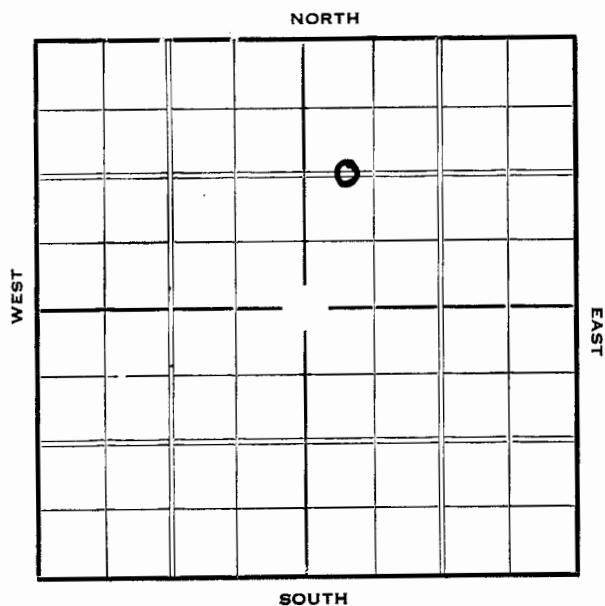


Section 11 Township 12 Range 18-WWell Number 2 - StaabCompany PhillipsSec. 11 Twp. 12 R. 18-WWell No. #2 Staab FarmPhillips Company1320 Ft. from N. Line Ft. from S. Line Ft. from E. Line440 Ft. from W. Line

Elev. 2122

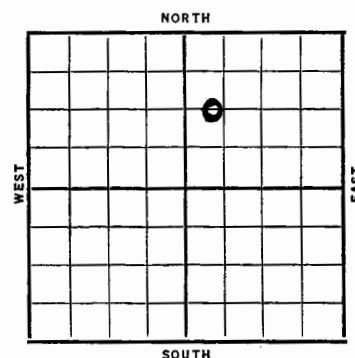

Date	REPORT
1937	
5/19	B. R. R.
5/28	Reaming @ 1230'.
6/4	10" @ 1247'. Drlg. 2330'.
6/11	Drlg. 3210'.
6/19	Sil. 3634'. T.D. 3635'.
	7" @ 3634'. RUST.
6/25	" " "
8/2	T.D. 3641'. 2400' oil in 5
	hrs. Swab 154 bbls. oil in
	4 hrs.
7/7	7" @ 3634'.
	Sil. 3634'.
	T.D. 3641'.
	Pot. 786 bbls.
	COMPLETED

Ellis KANSAS

Map No. 71 Sec. 11 Twp. 12 R. 18^wWell No. 2 - StaabPhillips Company
Contractor

FIRST REPORT

SECTION PLAT

		0	

1320 Ft. from N. Line

_____ Ft. from S. Line

_____ Ft. from E. Line

440 Ft. from W. Line

Location _____

Rig up _____

Drilling and Remarks:

B.R.R.

RECORD

Cased _____ in., _____ ft.

Sand _____

Gas _____

Oil _____

Total Depth _____

PRODUCTION

1st 24 hrs. Nat. _____

1st 24 hrs. after shot _____

Gas _____ Cu. Ft.

Dry Hole _____

Abandoned _____

Date

MAY 19 1937₁₉H. D. Hatfield Scout

Ellis KANSAS

Map No. _____ Sec. 11 Twp. 12 R. 18^wWell No. 2 - StaabPhillips Company
Contractor

COMPLETED

SECTION PLAT

		0	

1320 Ft. from N. Line

_____ Ft. from S. Line

_____ Ft. from E. Line

440
330 Ft. from W. Line

Location _____

Rig up _____

Drilling and Remarks:

Rot 786

RECORD

Cased 7 in., 3634 ft.Sand 511 3634

Gas _____

Oil _____

Total Depth 3641

PRODUCTION

1st 24 hrs. Nat. _____

1st 24 hrs. after shot _____

Gas _____ Cu. Ft.

Dry Hole _____

Abandoned _____

Date

JUL 7 1937₁₉H. D. Hatfield Scout

First report 1320' from N line
& 440' from W line.

RAY

Returned	
Cards	Paul
Tracing	Joe
France Map	
Scarborough Map	
Moody Map	✓
Scarborough Plat Book	
Moody Plat Book	

RAY

Returned	
Cards	Paul
Tracing	Joe
France Map	
Scarborough Map	
Moody Map	✓
Scarborough Plat Book	
Moody Plat Book	