

Ellis

Sec. 11 Twp. 12 R. 18-W

Section 11 Township 12 Range 18-W

Well No. #1 F. A. Dennon Farm

Well No. #1 F. A. Dennon

Gulf Company

Company Gulf

(Koblitz)


Ft. from N. Line

990 Ft. from S. Line


660 Ft. from E. Line

Ft. from W. Line

Elev. 2163

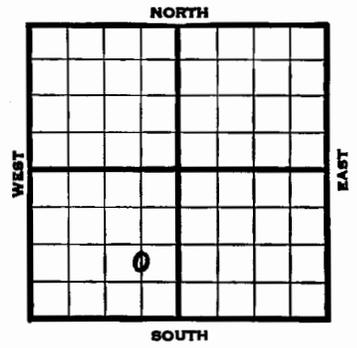

NORTH Koblitz Pool

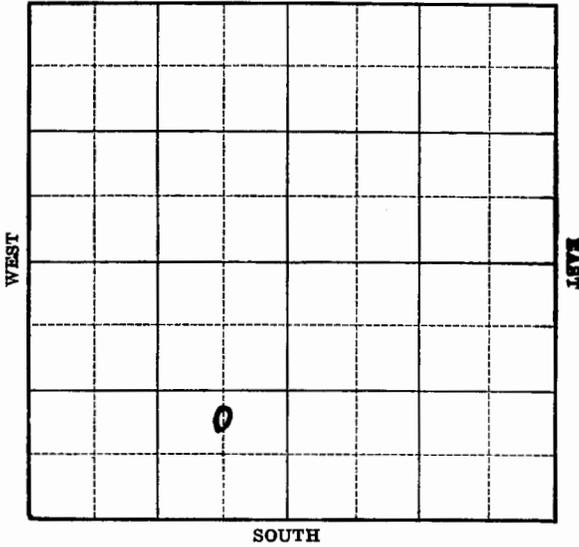

1939	REPORT
11/15	Rotary.
11/23	8" - 1393' Anhy 1404' Drlg. 2260'
11/29	Topeka 3165' Drlg. 3430'
12/7	Arb. 3670' 5" - 3670½' T.D. 3679' 1500' oil 5 hours.
12/14	T.D. 3680' 2000 acid. Pump 284 bbls. 10 hours.
12/20	Arb. 3670' 5½" - 3670½' 2000 acid. T.D. 3680' Depthograph pot. 19,701 bbls. 7% water. Maximum 2790 bbls.
	COMPLETED

Map No. 7/ Sec. 11 Twp. 12 R. 18W


Well No. 1 F. A. Dennam

Gulf Company

Contractor

FIRST REPORT
C N 1/2 SE SW

SECTION PLAT

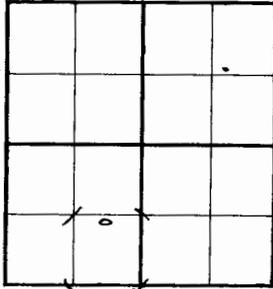

Ft. from N. Line

990 Ft. from S. Line

660 Ft. from E. Line

Ft. from W. Line

KOBLITZ POOL

Location

RECORD

Cased _____ in.; _____ ft.
Sand _____
Gas _____
Oil _____
Total Depth _____

PRODUCTION

1st 24 hrs. Nat. _____
1st 24 hrs. after shot _____
Gas _____ Cu. Ft.
Dry Hole _____
Abandoned _____

Rig up _____
Drilling and Remarks:
Rotary

Date

NOV 15 1939 19

S. J. LEWIS Scout

Map No. 7/ Sec. 11 Twp. 12 R. 18W

Well No. 1 F. A. Dennam


Gulf Company

Contractor

COMPLETED

C N 1/2 SE SW

SECTION PLAT

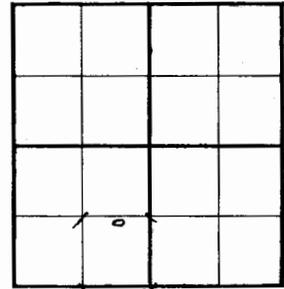

Ft. from N. Line

990 Ft. from S. Line

660 Ft. from E. Line

Ft. from W. Line

KOBLITZ POOL

Location

RECORD

Cased _____ in.; _____ ft.
Sand _____
Gas _____
Oil _____
Total Depth 3680

PRODUCTION

1st 24 hrs. Nat. _____
1st 24 hrs. after shot _____
Gas _____ Cu. Ft.
Dry Hole _____
Abandoned _____

Rig up _____
Drilling and Remarks:
2000 Acid
5 1/2 C 3690 1/2
Depthograph Pot.
1970 L 7% W
Map 2790

Date

DEC 20 1939 19

S. J. LEWIS Scout