



FORM 51 IOM 12-46 PETROL

Sec. 11 Twp. 12 R. 18-WSection 11 Township 12 Range 18WWell No. 1 KoernerCompany Derby et alWell No. #1 Koerner FarmDerby et al Company
Bemis Pool660 Ft. from N. Line

Ft. from S. Line

990 Ft. from E. Line

Ft. from W. Line

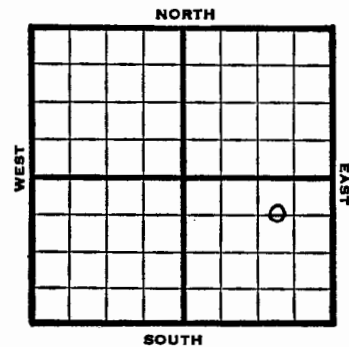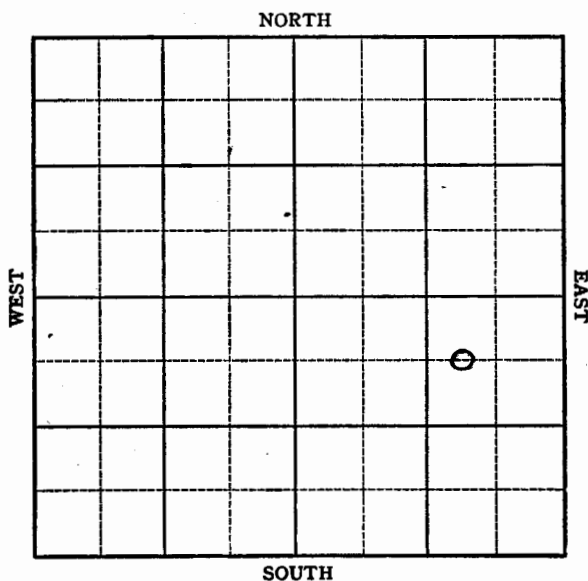

C W L N E S E

1947 Elev. 2130' REPORT

5/21	Location
5/27	"
6/3	"
6/10	8" @ 1378 Drig. 2705'
6/17	Bansing 3377' Arbuckle 3640-42 TD 5" @ 3641' Rust
6/24	"
7/1	"
7/8	"
7/16	Arbuckle 3628' 5" @ 3639' Pump 356 Pot. Gr. 36 T.D. 3641'

COMPLETED

Map No. 71 Sec. 11 Twp. 12 R. 18WWell No. 1 Koerner

Derby et al. Company

FIRST REPORT

Contractor

C W L NE SE


SECTION PLAT

660 Ft. from N. Line

Ft. from S. Line

990 Ft. from E. Line

Ft. from W. Line

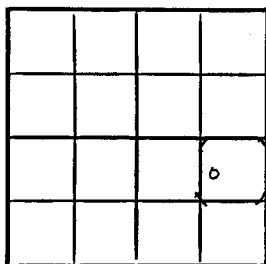

Ellis County

Location X

Rig up

Drilling and Remarks:

RECORD

Cased in, ft.

Sand

Gas

Oil

Total Depth

PRODUCTION

1st 24 hrs. Nat.

1st 24 hrs. after shot

Gas Cu. Ft.

Dry Hole

Abandoned

Date

MAY 21 1947 19

S. J. LEWIS

Scout

Map No. 71 Sec. 11 Twp. 12 R. 18WWell No. 1 Koerner

Derby et al.

Company

COMPLETE

Contractor

C W L NE SE


SECTION PLAT

660 Ft. from N. Line

Ft. from S. Line

990 Ft. from E. Line

Ft. from W. Line

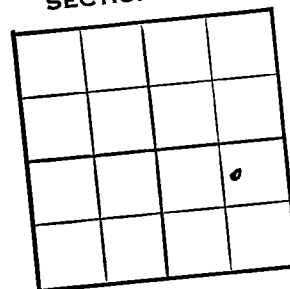

Ellis County

Location

Rig up

Drilling and Remarks:

CR 836285" @ 36 39Pump 356 Bx86 44

RECORD

Cased in, ft.

Sand

Gas

Oil

Total Depth 8641

PRODUCTION

1st 24 hrs. Nat.

1st 24 hrs. after shot

Gas Cu. Ft.

Dry Hole

Abandoned

Date

JUL 16 1947 19

S. J. LEWIS

Scout