


Section 11 Township 12 Range 18-W

Well Number..... 1 Staab

Company.....Phillips.

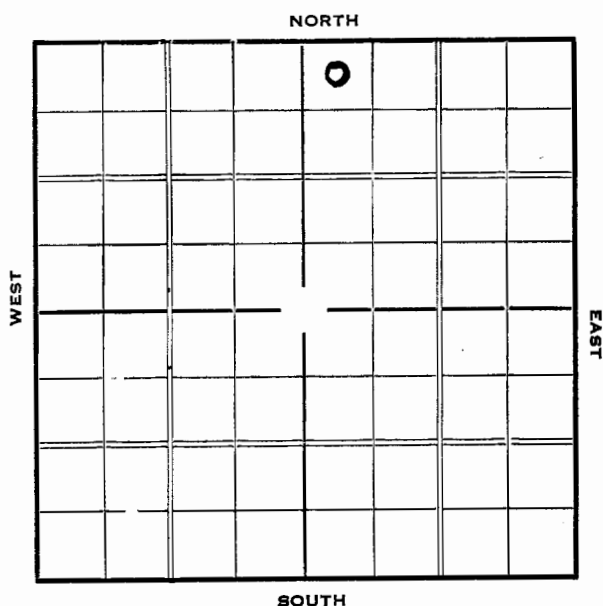

Sec. 11 Twp. 12 R. 18-W

Well No. #1 Staab Farm

Phillips Company


330 Ft. from N. Line

_____ Ft. from S. Line

Ft. from E. Line

330 Ft. from W. Line

Elev. 2113

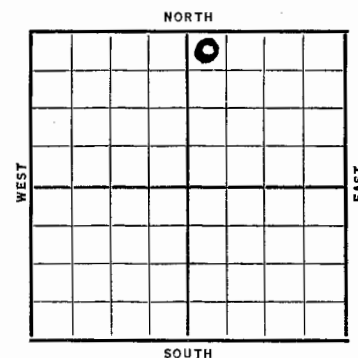[illegible]

1937

5/26 7" @ 3609'.

Perforated 5" liner 3630'.

Sil. 3624' (Corrected)

T.D. 3631'.

2000 Acid.

Pot. 2200 bbls.

COMPLETED

Map No. _____ Sec. 11 Twp. 12 R. 18WWell No. 1 StaabPhillips Company

Contractor

SECTION PLAT

		0	

320 Ft. from N. Line

_____ Ft. from S. Line

_____ Ft. from E. Line

330 Ft. from W. Line

FIRST REPORT

Location ✓

Rig up _____

Drilling and Remarks:

RECORD

Cased _____ in., _____ ft.

Sand _____

Gas _____

Oil _____

Total Depth _____

PRODUCTION

1st 24 hrs. Nat. _____

1st 24 hrs. after shot _____

Gas _____ Cu. Ft.

Dry Hole _____

Abandoned _____

Date

APR 14 1937 19S. J. LEWIS

Scout

Map No. _____ Sec. 11 Twp. 12 R. 18WWell No. 1 - StaabPhillips Company

Contractor

COMPLETED

SECTION PLAT

		0	

330 Ft. from N. Line

_____ Ft. from S. Line

_____ Ft. from E. Line

330 Ft. from W. Line

Location _____

Rig up _____

Drilling and Remarks:

2000 AcidPost-2200

Date

MAY 26 1937 19H. D. Hatfield

Scout

RECORD

Cased 7" - 3609 in., 3630 ft.Sand 5 1/2" Liner 3624Gas (corrected)

Oil _____

Total Depth 3631

PRODUCTION

1st 24 hrs. Nat. _____

1st 24 hrs. after shot _____

Gas _____ Cu. Ft.

Dry Hole _____

Abandoned _____