

KANSAS Ellis

KANSAS Ellis

Sec. 11 Twp. 12 R. 18W

Section 11 Township 12 Range 18W

Well No. 2 Koerner Farm

Well No. 2 Koerner

Derby Oil Company

Company Derby Oil

Burnett Pool

Burnett Pool


990 Ft. from N. Line

Ft. from S. Line


330 Ft. from E. Line

Ft. from W. Line

SE NE SE

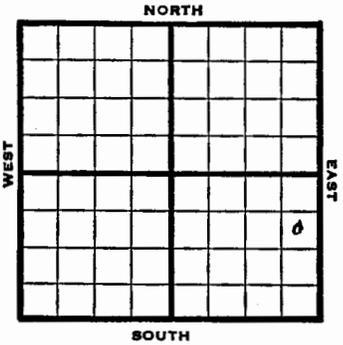

Burnett Pool NORTH

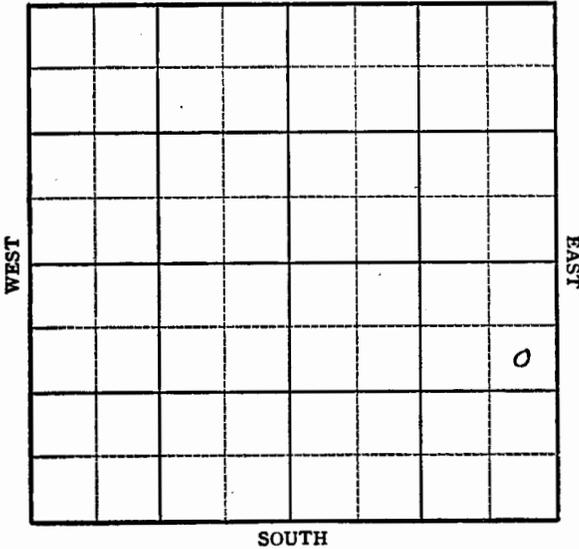

SOUTH

1948		Eli 2109'	REPORT
8/25	Location		
9/1	"		
9/8	8" @ 1861'		
	Drig 3540'		
9/14	Arb. 3633-35'		
	TD 3635'		
	5" @ 3633'		
9/21	TD 3640'	500 acid	
9/29	"		
10/6	"		
10/13	"		
10/20	TD 3640'		
	Arb 3633'		
	5" @ 3633'		
	Pump 29 oil Pot		
	36 ⁰ Gr.		
	Comp		
	COMPLETED		

ANALYSIS

Ellis County Kansas State

Map No. Sec. 11 Twp. 12 R. 18W

Well No. 2 Koerner

Derby Oil Company

FIRST REPORT

SE NE SE

SECTION PLAT

990 Ft. from N. Line

Ft. from S. Line

330 Ft. from E. Line

Ft. from W. Line

Burnett Pool
Remarks:

Location

Date
AUG 25 1948

Scout S. J. LEWIS

Map No. 77 Sec. 11 Twp. 12 R. 18W

Well No. 2 Koerner

Derby Oil Company

COMPLETE

Contractor

SE NE SE

E12109

SECTION PLAT

990 Ft. from N. Line

Ft. from S. Line

330 Ft. from E. Line

Ft. from W. Line

Ellis County

Location

Rig up

Drilling and Remarks:

*Cur 3633
5' 0033
Pump 29 11/18*

36 34

RECORD

Cased in, ft.

Sand

Gas

Oil

Total Depth 3440

PRODUCTION

1st 24 hrs. Nat.

1st 24 hrs. after shot

Gas Cu. Ft.

Dry Hole

Abandoned

Date

OCT 20 1948 19

S. J. LEWIS Scout