

Section 11 Township 12 Range 18-W


Sec. 11 Twp. 12 R. 18-W

Well Number #1 Koerner

Well No. #1 Koerner Farm _____

Company Gulf

Company Gulf

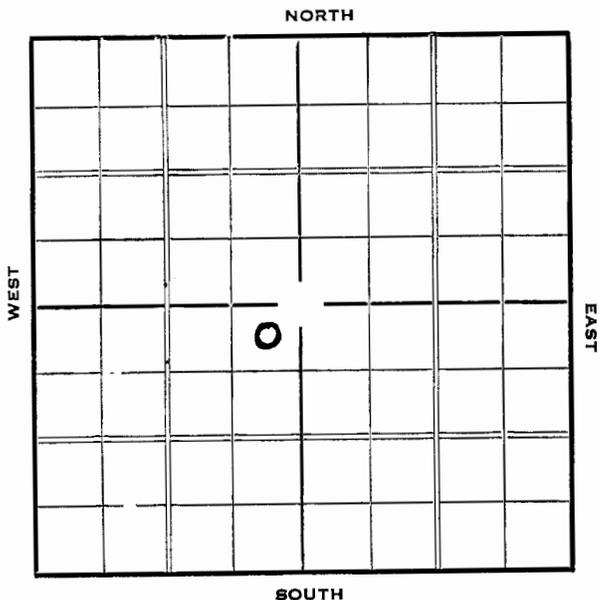


330 Ft. from N. Line

_____ Ft. from S. Line

330 Ft. from E. Line

_____ Ft. from W. Line

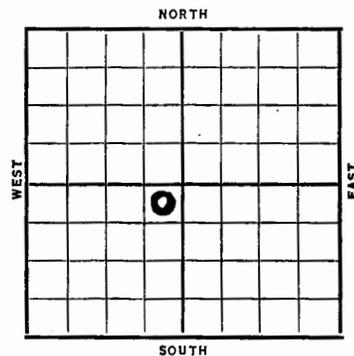

Date	REPORT
1937	
6/30	Cellar
7/9	Drlg. 885 $\frac{1}{2}$.
7/16	10" @ 1357'. Drlg. 1650'.
7/23	Drlg. 2955'.
7/30	Drlg. 3659'.
8/6	Sil. & 7" @ 3663'. T.D. 3672'. Swab 270 oil in 9 hours. 1000 acid.
8/11	7" @ 3663'. Si. 3363'. T.D. 3672'. 1000 acid. Pot. 1571 bbls.
	COMPLETED

Ellis KANSAS

Map No. _____ Sec. 11 Twp. 12 R. 18^a

Well No. 1-Koerner

Gulf Company
Contractor

COMPLETED

SECTION PLAT

	0		

330 Ft. from N. Line
____ Ft. from S. Line
330 Ft. from E. Line
____ Ft. from W. Line

Location _____

Rig up _____

Drilling and Remarks:

1000 Acid

Pat - 1571

RECORD

Cased 7 in., 3663 ft.
Sand 511 3663
Gas _____
Oil _____
Total Depth 3672

PRODUCTION

1st 24 hrs. Nat. _____
1st 24 hrs. after shot _____
Gas _____ Cu. Ft.
Dry Hole _____
Abandoned _____

Date

AUG 11 1937 19

H. D. Hatfield Scout

Ellis KANSAS

Map No. _____ Sec. 11 Twp. 12 R. 18^w

Well No. 1-Koerner

Gulf Company
Contractor

FIRST REPORT

SECTION PLAT

	0		

330 Ft. from N. Line
____ Ft. from S. Line
330 Ft. from E. Line
____ Ft. from W. Line

Location _____

Rig up _____

Drilling and Remarks:

Cellar

RECORD

Cased _____ in., _____ ft.
Sand _____
Gas _____
Oil _____
Total Depth _____

PRODUCTION

1st 24 hrs. Nat. _____
1st 24 hrs. after shot _____
Gas _____ Cu. Ft.
Dry Hole _____
Abandoned _____

Date

130 1937 19

H. D. Hatfield Scout