

Section 11 Township 12 Range 18-W


Sec. 11 Twp. 12 R. 18-W

Well Number 2 Staab

Well No. #2 Staab Farm

Carter Company

Company Carter

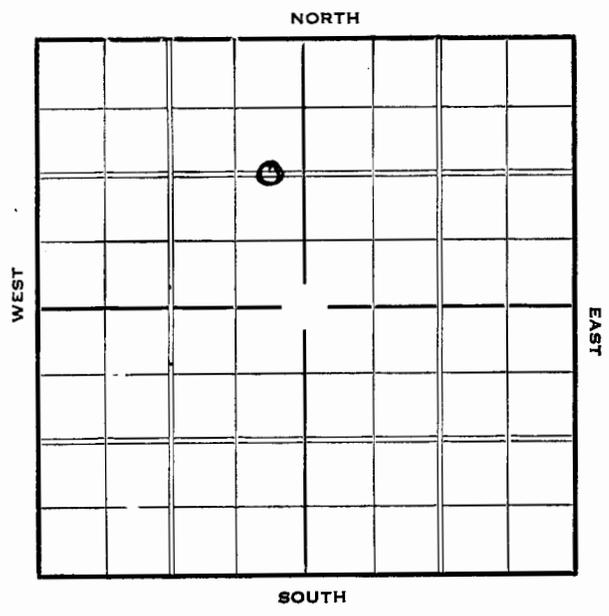


1320 Ft. from N. Line

Ft. from S. Line

330 Ft. from E. Line

Ft. from W. Line

Elev. 2118

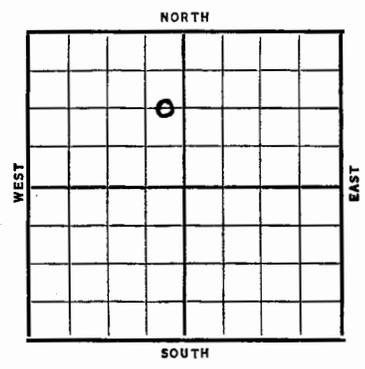

| Date | REPORT |
|------|--|
| 1937 | |
| 4/7 | R O G |
| 4/16 | Rigging up |
| 4/23 | Anhydrate 1353'. 10" @ 1358'. WOC. Drlg. 1371 |
| 4/30 | Drlg. 2450'. |
| 5/7 | Topeka 3050'. Small show oil 3103-10'. Drlg. 3270'. |
| 5/14 | Sil. 3625'. S.O. Rng. 7". |
| 5/21 | 7" @ 3625'. T.D. 3629'. 2500' oil in 2 hours. |
| 5/26 | 7" @ 3625'. Sil. 3625'. T.D. 3629'. Pot. 1693 bbls. |
| | COMPLETED |

Map No. _____ Sec. 11 Twp. 12 R. 18W

Well No. 2 Staat

Carter Company

Contractor

SECTION PLAT

| | | | |
|--|--|---|--|
| | | | |
| | | 0 | |
| | | | |
| | | | |
| | | | |

1320 Ft. from N. Line

_____ Ft. from S. Line

330 Ft. from E. Line

_____ Ft. from W. Line

TEST REPORT

Location _____

Rig up _____

Drilling and Remarks:

ROG

RECORD

Cased _____ in., _____ ft.

Sand _____

Gas _____

Oil _____

Total Depth _____

PRODUCTION

1st 24 hrs. Nat. _____

1st 24 hrs. after shot _____

Gas _____ Cu. Ft.

Dry Hole _____

Abandoned _____

Date _____

APR 7 1937 19 _____

LEWIS

Scout

Map No. _____ Sec. 11 Twp. 12 R. 18W

Well No. 2 Staat

Carter Company

Contractor

COMPLETED

SECTION PLAT

| | | | |
|--|--|---|--|
| | | | |
| | | 0 | |
| | | | |
| | | | |
| | | | |

1320 Ft. from N. Line

_____ Ft. from S. Line

330 Ft. from E. Line

_____ Ft. from W. Line

Location _____

Rig up _____

Drilling and Remarks:

Pot - 1693

RECORD

Cased 7 in., 3625 ft.

Sand 511 3625

Gas _____

Oil _____

Total Depth 3629

PRODUCTION

1st 24 hrs. Nat. _____

1st 24 hrs. after shot _____

Gas _____ Cu. Ft.

Dry Hole _____

Abandoned _____

Date _____

MAY 26 1937 19 _____

H. D. Hatfield

Scout