

Section 11 Township 12 Range 18-W


Sec. 11 Twp. 12 R. 18-W

Well Number #3 Staab


Well No. #3 Staab Farm _____

Company Phillips

Phillips Company

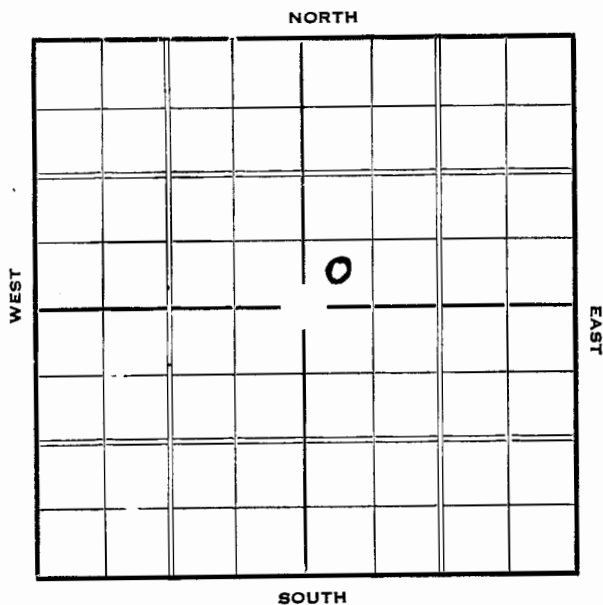

_____ Ft. from N. Line
330 Ft. from S. Line
 _____ Ft. from E. Line
330 Ft. from W. Line

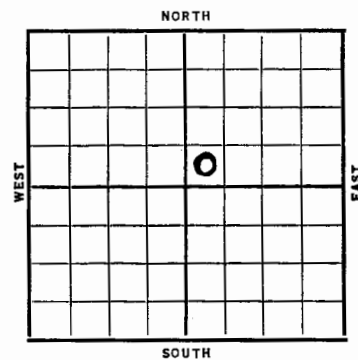

Date	REPORT
1937	
6/30	Mat.
7/9	T.D. 1305'. Reaming.
7/16	10" @ 1285'. Drlg. 2173'.
7/23	Drlg. 3250'.
7/30	Drlg. 3603'.
8/6	Sil. 3684' & 7". T.D. 3688'.
8/13	T.D. 3690'. 2000 acid.
8/20	" " " "
8/25	7" @ 3684'
	Sil 3684'
	TD 3690'
	2000 acid
	2000 acid
	Pump 54.9/4
	Pump 22.48/4
	Pot 135
	1% water
	COMPLETED

Ellis KANSAS

Map No. _____ Sec. 11 Twp. 12 R. 18^w

Well No. 3-Staab

Phillips Company

Contractor

FIRST REPORT

SECTION PLAT

		0	

_____ Ft. from N. Line

330 Ft. from S. Line

_____ Ft. from E. Line

330 Ft. from W. Line

Location _____

RECORD

Cased _____ in., _____ ft.

Sand _____

Gas _____

Oil _____

Total Depth _____

PRODUCTION

1st 24 hrs. Nat. _____

1st 24 hrs. after shot _____

Gas _____ Cu. Ft.

Dry Hole _____

Abandoned _____

Date

JUN 30 1937 19

H. D. Hatfield Scout

Ellis KANSAS

Map No. _____ Sec. 11 Twp. 12 R. 18^w

Well No. 3-Staab

Phillips Company

Contractor

COMPLETED

SECTION PLAT

		0	

_____ Ft. from N. Line

330 Ft. from S. Line

_____ Ft. from E. Line

330 Ft. from W. Line

Location _____

RECORD

Cased 7 in., 3684 ft.

Sand 511 3684

Gas _____

Oil _____

Total Depth 3690

PRODUCTION

1st 24 hrs. Nat. _____

1st 24 hrs. after shot _____

Gas _____ Cu. Ft.

Dry Hole _____

Abandoned _____

Date

AUG 25 1937 19

H. D. Hatfield Scout

2000 Acid
2000 A -
Pump 54.9/4
22.48/4
Pot - 135 190 water