

Sec. 11 Twp. 12 R. 18W

Section 11 Township 12 Range 18W

Well No. S-Koerner Farm

Well No. #2 Koerner

Gulf Company

Company Gulf



330 Ft. from N. Line

Ft. from S. Line

990 Ft. from E. Line

Ft. from W. Line

Elev. 2152

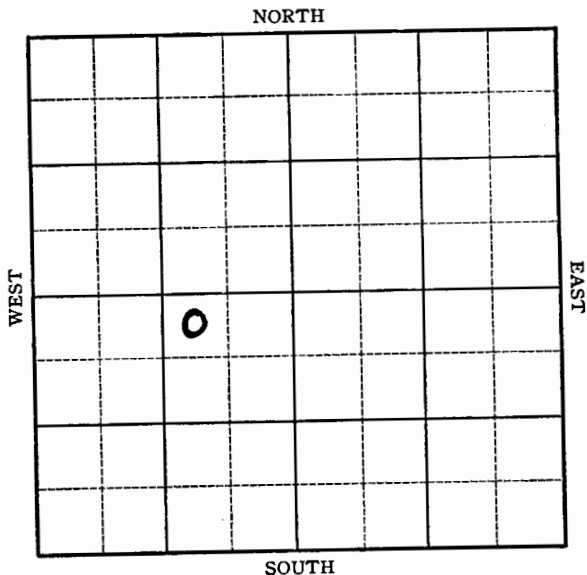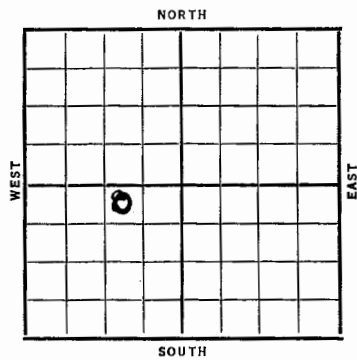

Date	REPORT
1937	
8/11	R.U.R.
8/20	13" @ 1368'. WOC.
8/28	Drlg. 2585'.
9/3	Drlg. 3414'.
9/10	Sil. & 6" @ 3666'.
	T.D. 3677'. 2000' oil
	Swabbing.
9/15	6" @ 3666'
	Sil 3666'
	TD 3677'
	2000 acid
	P - 200.52 & 183/4
	Pot 1100
	COMPLETED

Ellis KANSAS

Map No. _____ Sec. 11 Twp. 12 R. 18^w

Well No. 2-Koerner

Gulf Company

Contractor

FIRST REPORT

SECTION PLAT

	0		

330 Ft. from N. Line

_____ Ft. from S. Line

990 Ft. from E. Line

_____ Ft. from W. Line

Location _____

Rig up _____

Drilling and Remarks:

R.U.R.

RECORD
 Cased _____ in., _____ ft.
 Sand _____
 Gas _____
 Oil _____
 Total Depth _____

PRODUCTION
 1st 24 hrs. Nat. _____
 1st 24 hrs. after shot _____
 Gas _____ Cu. Ft.
 Dry Hole _____
 Abandoned _____

Date

AUG 11 1937 19 H. D. Hatfield Scout

Ellis KANSAS

Map No. _____ Sec. 11 Twp. 12 R. 18^w

Well No. 2-Koerner

Gulf Company

Contractor

COMPLETED

SECTION PLAT

	0		

330 Ft. from N. Line

_____ Ft. from S. Line

990 Ft. from E. Line

_____ Ft. from W. Line

Location _____

Rig up _____

Drilling and Remarks:

200 acid

f. 200.524 x 18 3/4

Pot- 1100

RECORD
 Cased 6 in., 3666 ft.
 Sand 51 3666
 Gas _____
 Oil _____
 Total Depth 3677

PRODUCTION
 1st 24 hrs. Nat. _____
 1st 24 hrs. after shot _____
 Gas _____ Cu. Ft.
 Dry Hole _____
 Abandoned _____

Date

SEP 15 1937 19 H. D. Hatfield Scout