

Sec. 11 Twp. 12 R. 18-W

Well No. #3 Koerner Farm

Gulf

Company

(Walters Arb.)


990 Ft. from N. Line

Ft. from S. Line

660 Ft. from E. Line

Ft. from W. Line

Elv. 2176

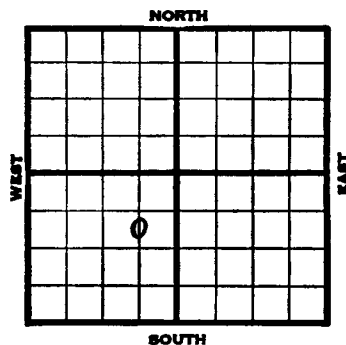


1939	REPORT
12/20	Rotary.
12/28	Anhy 1415' 8" - 1401'
	Drlg. 1640'
1940	
1/4	Drlg. 3431'
1/11	Arb. 3686' 5 1/2" - 3687'
	T.D. 3688' RUST.
1/18	T.D. 3689' Swab 135 bbls. in 5 hours.
1/24	Arb. 3686'
	5 1/2" - 3687'
	T.D. 3689'
	Sonimeter potential 6143 bbls.
	Maximum 3000 bbls.
	COMPLETED

Section 11 Township 12 Range 18-W

Well No. #3 Koerner

Company Gulf

NORTH Walters Arb. Pool

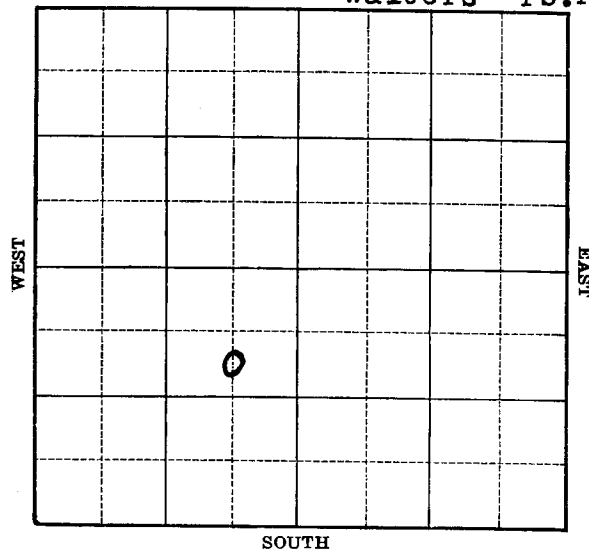

Ellis KANSAS

Map No. 71 Sec. 11 Twp. 12 R. 18WWell No. 3 Koerner

Gulf

Company

Contractor

COMPLETED

C S $\frac{1}{2}$ NE SW

SECTION PLAT

990 Ft. from N. Line

Ft. from S. Line

660 Ft. from E. Line

Ft. from W. Line

WALTERS ARB. POOL

Location

RECORD

Cased _____ in., _____ ft.

Sand _____

Gas _____

Oil _____

Total Depth 3689

PRODUCTION

1st 24 hrs. Nat. _____

1st 24 hrs. after shot _____

Gas _____ Cu. Ft.

Dry Hole _____

Abandoned _____

Date

24 1940

19

Scout

Ellis KANSAS

Map No. 71 Sec. 11 Twp. 12 R. 18WWell No. 3 Koerner

Gulf

Company

Contractor

FIRST SECTION

C S $\frac{1}{2}$ NE SW

SECTION PLAT

990 Ft. from N. Line

Ft. from S. Line

660 Ft. from E. Line

Ft. from W. Line

WALTERS ARB. POOL

Location

RECORD

Cased _____ in., _____ ft.

Sand _____

Gas _____

Oil _____

Total Depth _____

PRODUCTION

1st 24 hrs. Nat. _____

1st 24 hrs. after shot _____

Gas _____ Cu. Ft.

Dry Hole _____

Abandoned _____

Date

19

Scout