


Ellis

KANSAS

Section 11 Township 12 Range 18WWell No. #1 StaabCompany W. E. Wickizer

NORTH

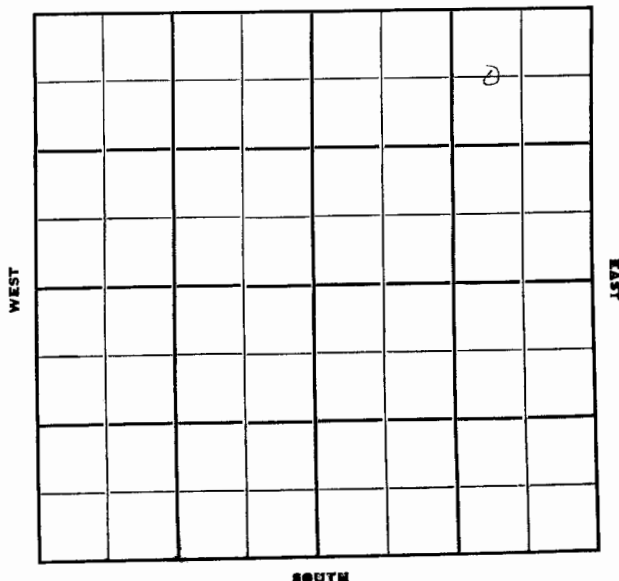

SOUTH

Ellis

ANSAS

Sec. 11 Twp. 12 R. 18-WWell No. #1 Staab Farm

W E Wickizer


Company

Walter Pool

660 Ft. from N. Line Ft. from S. Line990 Ft. from E. Line Ft. from W. Line

C W L N E N E

NORTH

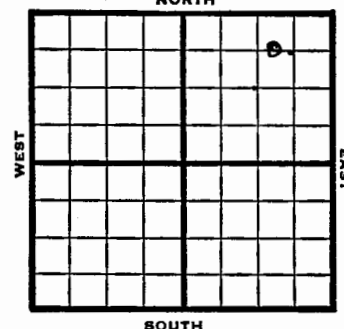

SOUTH

1950 Elev 2117' REPORT

2/22 Spud 2-19-50
 8 5/8" @ 137'
 Drlg 1400'
 3/22 8 5/8" @ 137'
 Anhy 1385-1430'
 Hee'ner 3328'
 Lens 3367'
 Arb. 3645'
 5" @ 3646'
 TD 3651'
 Fill up 1500' oil
 Swab 11 BOPH
 Comp 205 BOPD
 Comp

COMPLETED

Kansas

Walter Pool

Map No. _____ Sec. 11 Twp. 12 R. 18W

Well No. 1 Staab

W. E. Wickizer Company

Contractor

C W L ME NE

SECTION PLAT



630 Ft. from N. Line

Ft. from S. Line

990 Ft. from E. Line

Ft. from W. Line

Ellis County

Location

RECORD

Cased _____ in., _____ ft.

Sand _____

Gas _____

Oil _____

Total Depth _____

PRODUCTION

1st 24 hrs. Nat. _____

1st 24 hrs. after shot _____

Gas _____ Cu. Ft.

Dry Hole _____

Abandoned _____

Rig up _____

Drilling and Remarks:

Spud 2-19-50

8 5/8" @ 137

drlg. 1400

Date

FEB 22 1950 19

J. E. TYRA Scout

Kansas

Walters Pool


Map No. _____ Sec. 11 Twp. 12 R. 18W

Well No. 1 Staab

W. E. Wickizer Company

Contractor

C W L ME NE

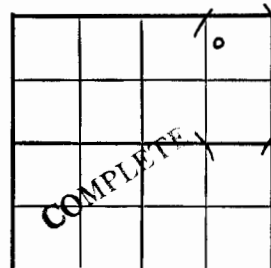E1. 2117
SECTION PLAT

660 Ft. from N. Line

Ft. from S. Line

990 Ft. from E. Line

Ft. from W. Line

Ellis County

Location

RECORD

Cased _____ in., _____ ft.

Sand _____

Gas _____

Oil _____

Total Depth _____

PRODUCTION

1st 24 hrs. Nat. _____

1st 24 hrs. after shot _____

Gas _____ Cu. Ft.

Dry Hole _____

Abandoned _____

Rig up _____

Drilling and Remarks:

8 5/8" @ 137

Anky 1385-1430

Nebner 3328

Pans. 3369

arb. 3645

5" @ 3646

T.D. 3651

Fill up 1500' oil

Sewall 11 bopd

Comp. 205 bopd

Date

MAR 22 1950 19

J. E. TYRA Scout