


Section 11 Township 12 Range 18-W

Well Number #1 Staab

Company I.T.I.O.

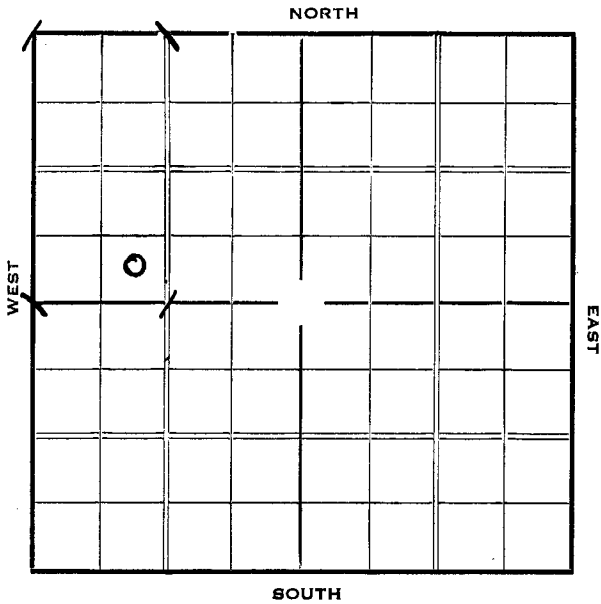

Sec. 11 Twp. 12 R. 18-W

Well No. #1 Staab Farm


I.T.I.O. Company

Ft. from N. Line

330 Ft. from S. Line

Ft. from E. Line

990 Ft. from W. Line

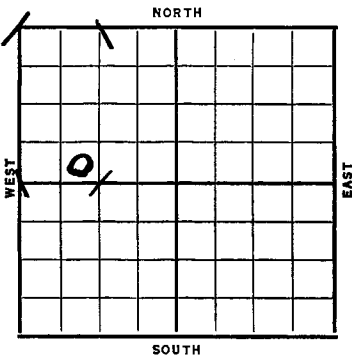

Date	REPORT
1937	
7/21	Cellar
7/30	B. R.
8/6	T.D. 1185'. Rng. pipe.
8/13	15" @ 102'. 10" @ 1187'.
	WOC.
8/20	Drlg. 3065'.
8/28	Sil. & 7" @ 3656'.
	T.D. 3666'. Sat.
9/3	T.D. 3666'. 1300' oil 35
	Min. 1750' 4 hrs. C.O.
9/10	T.D. 3669'. Taking pot.
9/15	7" @ 3656'
	Sil 3656'
	TD 3669'
	3000 acid
	P - 251/4 & 249/4
	Pot 1496
	COMPLETED

Ellis KANSAS

Map No. _____ Sec. 11 Twp. 12 R. 18^WWell No. 1- StaabI. T. O. Company

Contractor

COMPLETED

SECTION PLAT

	0		

_____ Ft. from N. Line

330 Ft. from S. Line

_____ Ft. from E. Line

990 Ft. from W. Line

Location _____

Rig up _____

Drilling and Remarks:

3000 acidP- 25 1/4 x 24 1/4Lot- 1496

RECORD

Cased 7 in. 3656 ft.Sand 511 3656

Gas _____

Oil _____

Total Depth 3669

PRODUCTION

1st 24 hrs. Nat. _____

1st 24 hrs. after shot _____

Gas _____ Cu. Ft.

Dry Hole _____

Abandoned _____

Date

SEP 15 1937 19 H. D. Hatfield Scout

Ellis

Map No. 71 Sec. 11 Twp. 12 R. 18^WWell No. 1- StaabI. T. O. Company

Contractor

FIRST REPORT

SECTION PLAT

	0		

_____ Ft. from N. Line

330 Ft. from S. Line

_____ Ft. from E. Line

990 Ft. from W. Line

Location _____

Rig up _____

Drilling and Remarks:

Cellar

RECORD

Cased _____ in., _____ ft.

Sand _____

Gas _____

Oil _____

Total Depth _____

PRODUCTION

1st 24 hrs. Nat. _____

1st 24 hrs. after shot _____

Gas _____ Cu. Ft.

Dry Hole _____

Abandoned _____

Date

JUL 21 1937 19 H. D. Hatfield Scout