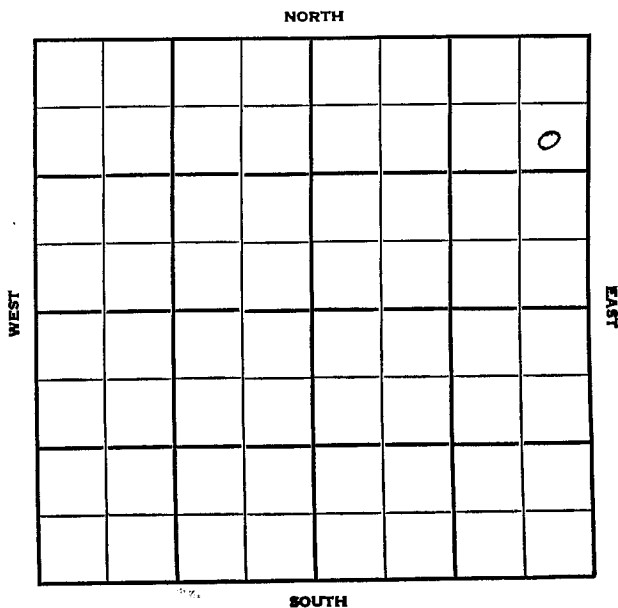


Ellis

KANSAS

Section 11 Township 12 Range 18WWell No. #5 StaabCompany Wick Petroleum

Ellis

KANSAS

SEC. <u>11</u>	TWP. <u>12</u>	R. <u>18W</u>
----------------	----------------	---------------

WELL NO.

#5 Staab

FARM

COMPANY

Wick Petroleum

CONTRACTOR

Wick

Walters Pool

990


Ft. from N. Line

Ft. from S. Line

330

Ft. from E. Line

Ft. from W. Line

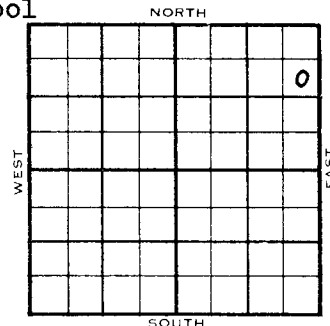

SE NE NE

1955

ELEVATION

2109'

REPORT

4/6

Spud 4-3-55

8" @ 194'

Drlg. 360'

5/25

Top 3085; Heeb 3316; Lsg 3364; Arb 3630; TD 3688;
 8" 194; 5½" 3688; CO; DP CO 3686;
 24/3680-86; bail 3 go plus 20 gwph;
 PB 3670; 16/3654-58; test oil & wtr;
 8/3654-56; oil & wtr; sqz perfs;
 12/3657½-58½; 500A; fill 1400' fluid
 25% wtr; swb 6½ boph 15% wtr 3 hrs;
 pmp 25 bopd 20% wtr from Arb
 3657½-58½

COMPLETED

County	Ellis		State	Kansas	
Sec.	11	(Blk. Twp.)	12	(Sur. Rge.)	18W
Operator	Wick Petroleum				
Well No.	5	Farm	Staab		
Elev.			Location	SE NE NE	
o FIRST REPORT			990 Ft. From	N Line	NE
			330 Ft. From	E Line	Quarter
			1st. Report	APR	6 1955
			Completion		
			Remarks	Wick - Contr.	
Spudding Date			4-3-55		
Drig. Data			Walters Pool		
8" @ 194			drlg. 360		

FABEN GILSTRAP