

O. W. D. D

Ellis

FORM 51 25M 3-49 PETROL

KANSAS

FORM 252-B
IOM 9-49 PETROL

O. W. D. D

Ellis

KANSAS

Sec. 11 Twp. 12 R. 18W

Section 11 Township 12 Range 18-W

Well No. #10 A. V. Staab

Company Carter Oil

Well No. #10 A. V. Staab Farm

Carter Oil Company

Contractor

Walters



660' Ft. from N. Line

Ft. from S. Line

Ft. from E. Line

990' Ft. from W. Line

C E/2 NW NE

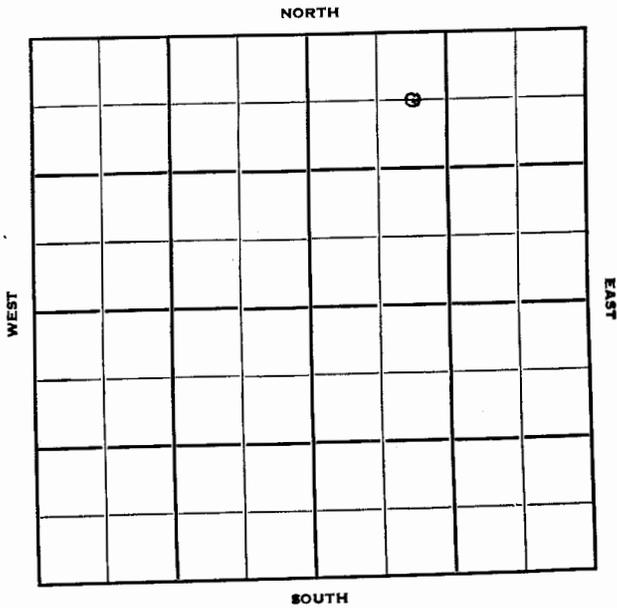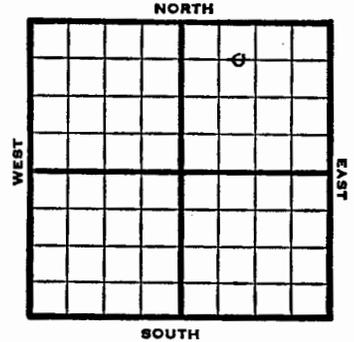

1950	Elev 2123	REPORT
5/31	Location	
8/23	10 3/4" @ 1375	
	Heeb 3328	Dodge 3347
	Dougals 3363	Lans 3382
	DST 3465-76 opn 1 hr rec 5' mud	
	Arb 3650	
	7" @ 3615	
	TD 3656	
	B/20 goph 3000 A	
	B/32 goph DD 3659	
	B/52 goph 1000 A, P/67 bo, P/17 bo	
	52 bwpd, P/15 bo 43 bw	
	Comp 9 bo 50 bwpd	
	Completed	
	COMPLETED	
	O. W. D. D	
1952	Arb. 3650 Prod 7" @ 3651'	OTD 3659
5/7	DD Granite W 4185'	TD 4190
	5" @ 3866'	DP CO 4190
	5 1/2" @ 3649'	Abd for SWD
	FIRST REPORT	
	ABANDONED	

County **Ellis** State **Kansas**
 Sec. **11** (Blk. Twp.) **12** (Sur. Rge.) **18W** Map No.
 Operator **Carter**
 Well No. **10** Farm **Staab**
 Elev. **2123 DP** Location **C E/2 NW NE**

660 Ft. From **N** Line **NE**
990 Ft. From **W** Line **Quarter**
 Ist. Report **MAY 7 1952**
 Completion **MAY 7 1952**
 Remarks **OWDD for SWD**
O. W. D. D
 Spudding Date

Drig. Data
Arb 3650 Prod. 7" @ 3651 OTD 3659 DD Granit
W 4185 TD 4190 5" @ 3666 DP CO 4190
3 1/2" @ 3649 Abd for SWD

J. G. MCGEHEE

County **Ellis** State **Kansas**
 Sec. **11** (Blk. Twp.) **12** (Sur. Rge.) **18W** Map No.
 Operator **Carter Oil**
 Well No. **10** Farm **A. V. Staab**
 Elev. **2123** Location **C E L NWNE**

660 Ft. From **N** Line **NE**
990 Ft. From **W** Line **Quarter**
 Ist. Report
 Completion **AUG 23 1950**
 Remarks
Walters Pool
 Spudding Date

Drig. Data **Oil well TD 3659**
10 3/4" @ 1375 Heeb. 3328 Dodge 3347
Douglas 3363 Lans. 3382 DST 3465-76
open 1 hr. Rec. 5' mud Arb. 3650
7" @ 3651 TD 3656 B/ 20 goph 3000 A
B/ 32 goph DD 3659 B/ 52 goph 1000 A
P/ 67 bo P/ 17 bo 52 bwpd P/ 15 bo 43 bw
Comp. 9 bo 50 bwpd

J. E. TYRA

Map No. _____ Sec. 11 Twp. 12 R. 13W

Well No. 10 A. V. Staab

Carter Oil _____ Company

_____ Contractor

0 1/2


SECTION PLAT

660 Ft. from N. Line

_____ Ft. from S. Line

_____ Ft. from E. Line

660 Ft. from W. Line

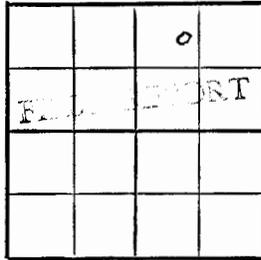

Ellis

Location X

Rig up _____

Drilling and Remarks:

RECORD

Cased _____ in., _____ ft.

Sand _____

Gas _____

Oil _____

Total Depth _____

PRODUCTION

1st 24 hrs. Nat. _____

1st 24 hrs. after shot _____

Gas _____ Cu. Ft.

Dry Hole _____

Abandoned _____

Date

MAY 31 1950

19

Scout