

Section 11 Township 12 Range 18-W


Sec. 11 Twp. 12 R. 18-W

Well Number 3 - Staab


Well No. #3 Staab Farm

Carter Company

Company Carter

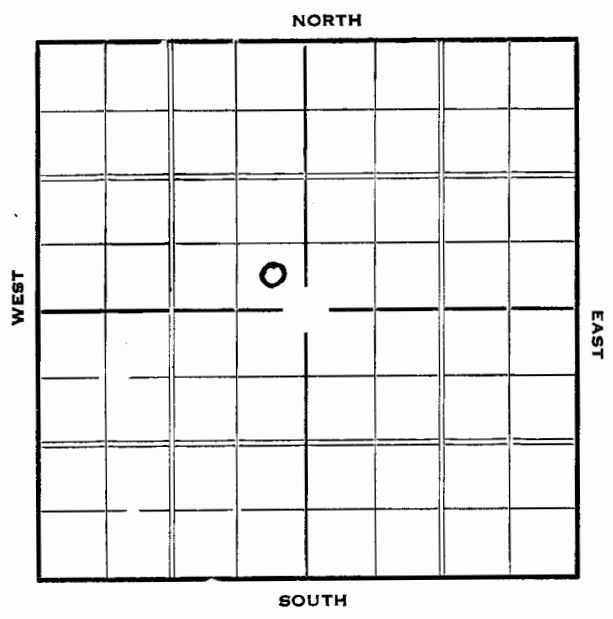

_____ Ft. from N. Line
 _____ 330 Ft. from S. Line
 _____ 330 Ft. from E. Line
 _____ Ft. from W. Line
 Elev. 2131

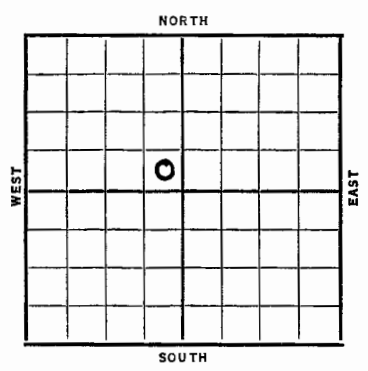

Date	REPORT
1937	
4/28	Location
5/7	Pits.
5/14	Rot. rig.
5/21	12" @ 1565'. Anhy 1364'.
5/28	10" @ 1377'. Drlg. 2500'.
6/4	Topeka 3070'. Drlg. 3590'.
6/11	Sil. 3649'. 7" @ 3648'.
	T.D. 3655'. Bailing.
6/16	7" @ 3648'.
	Sil. 3649'.
	T.D. 3655'.
	1500 acid.
	Pot. 1002 bbls.
	COMPLETED

Ellis KANSAS

Map No. _____ Sec. 11 Twp. 12 R. 18^w

Well No. 3- Staab

Carter Company

Contractor

FIRST REPORT

SECTION PLAT

	0		

_____ Ft. from N. Line

330 Ft. from S. Line

330 Ft. from E. Line

_____ Ft. from W. Line

Location

RECORD

Cased _____ in., _____ ft.

Sand _____

Gas _____

Oil _____

Total Depth _____

PRODUCTION

1st 24 hrs. Nat. _____

1st 24 hrs. after shot _____

Gas _____ Cu. Ft.

Dry Hole _____

Abandoned _____

Date

APR 28 1937

19

H. D. Hatfield Scout

Ellis KANSAS

Map No. 71 Sec. 11 Twp. 12 R. 18^w

Well No. 3- Staab

Carter Company

Contractor

COMPLETED

SECTION PLAT

	0		

_____ Ft. from N. Line

330 Ft. from S. Line

330 Ft. from E. Line

_____ Ft. from W. Line

Location _____

RECORD

Cased 7 in., 3648 ft.

Sand 511 3649

Gas _____

Oil _____

Total Depth 3635

PRODUCTION

1st 24 hrs. Nat. _____

1st 24 hrs. after shot _____

Gas _____ Cu. Ft.

Dry Hole _____

Abandoned _____

Drilling and Remarks:

1500 Acid

Pat 1002

Date

JUN 16 1937 19

H. D. Hatfield

Scout