
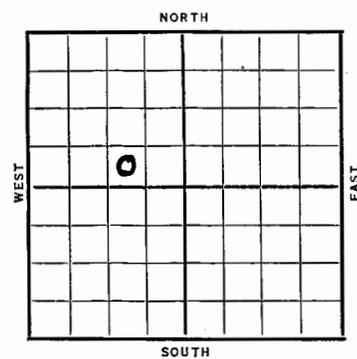


Form 51-5M 5-37 Petrol

Section 11 Township 12 Range 18-W
 Well No. 4 Staab
 Company Carter

Sec. 11 Twp. 12 R. 18-W
 Well No. #4 Staab Farm _____
 Company Carter

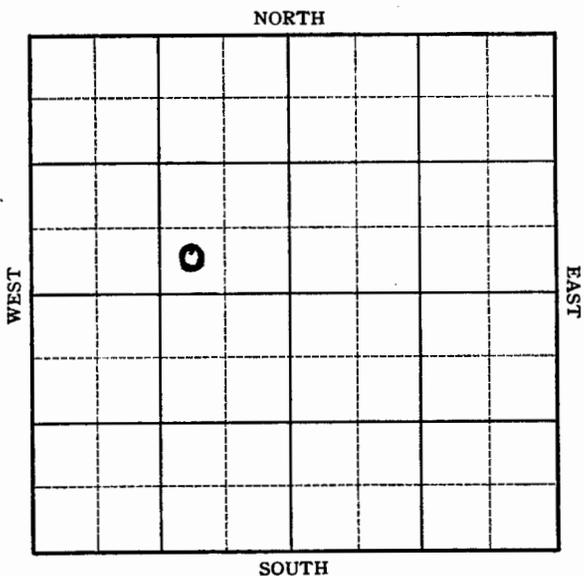

_____ Ft. from N. Line
330 Ft. from S. Line
990 Ft. from E. Line
 _____ Ft. from W. Line
 Elev. 2134

Date	REPORT
1937	
5/26	Location
6/4	R. Rig
6/11	Drilg. 165'.
6/19	Anhy 1372'. 10" @ 1206'. T.D. 1378'. WOC.
6/25	Drilg. 2996'.
7/2	Sil. 3651-56' T.D. Rng. 7".
7/9	7" @ 3651'. 2400' oil in 10 hours.
7/14	7" @ 3651'. Sil. 3651'. T.D. 3656'. 1500 acid. Pot. 1146 bbls. 24 hrs. Down 1 1/4 hrs.
	COMPLETED

Ellis KANSAS

Map No. _____ Sec. 11 Twp. 12 R. 18^W

Well No. 4-Stack
Carter Company

Contractor

COMPLETED

SECTION PLAT

_____ Ft. from N. Line
330 Ft. from S. Line
990 Ft. from E. Line
_____ Ft. from W. Line

	0		

Location _____

Rig up _____
Drilling and Remarks:

1500 Acid

Pat - 1146/24

Down 1 1/4 hrs

RECORD

Cased 7 in., 3651 ft.
Sand 511 3651
Gas _____
Oil _____
Total Depth 3656

PRODUCTION

1st 24 hrs. Nat. _____
1st 24 hrs. after shot _____
Gas _____ Cu. Ft.
Dry Hole _____
Abandoned _____

Date
JUL 14 1937 19

H. D. Hatfield Scout

Ellis KANSAS

Map No. _____ Sec. 11 Twp. 12 R. 18^W

Well No. 4-Stack
Carter Company

Contractor

FIRST REPORT

SECTION PLAT

_____ Ft. from N. Line
330 Ft. from S. Line
990 Ft. from E. Line
_____ Ft. from W. Line

	0		

Location _____

Rig up _____
Drilling and Remarks:

RECORD

Cased _____ in., _____ ft.
Sand _____
Gas _____
Oil _____
Total Depth _____

PRODUCTION

1st 24 hrs. Nat. _____
1st 24 hrs. after shot _____
Gas _____ Cu. Ft.
Dry Hole _____
Abandoned _____

Date
MAY 26 1937 19

H. D. Hatfield Scout