


Ellis KANSAS

Section 11 Township 12 Range 18WWell No. #1 ~~Deman~~ WiesnerCompany Heathman Drlg.

Walters Pool

NORTH

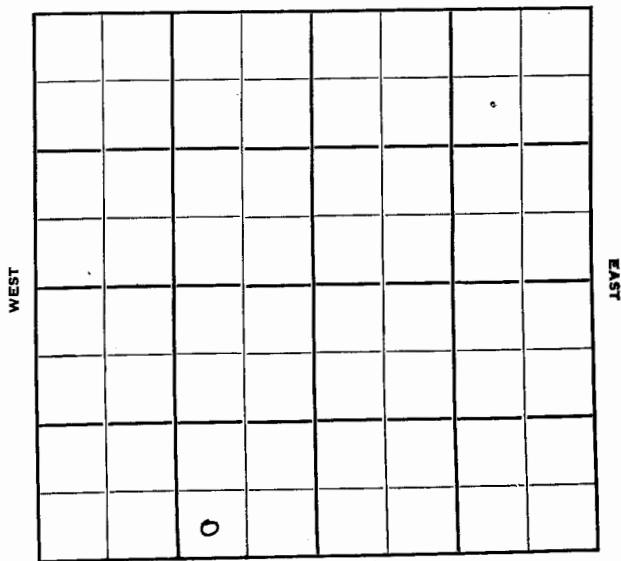

SOUTH

Ellis KANSAS


Sec. 11 Twp. 12 R. 18W ✓Well No. #1 ~~Deman~~ Wiesner FarmHeathman Drlg. Company
Walters Pool (Heathman Drlg, Contr.)

_____ Ft. from N. Line

330' Ft. from S. Line990' Ft. from E. Line

_____ Ft. from W. Line

SW SE SW

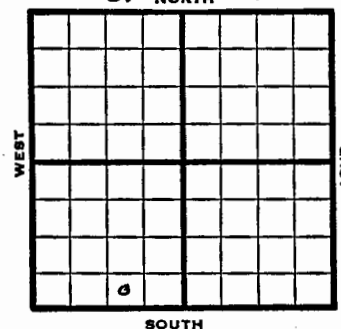

1949 Elev 2154' REPORT

12/21 8" @ 160'
 Anhy 1397'
 Drlg. 1513'
 12/28 Arb. 3673'-75'
 TD 3675
 5" @ 3674'

1950
 1/11 TD 3686'
 8" @ 160'
 5" @ 3674'
 Perf 23/3425-30
 Swb 2 bbls wtr pr hr
 D&A
 Anhy 1397'
 Simp 3656'
 Arb. 3673-55 TD
 Aband.

ABANDONED


Map No. _____ Sec. 11 Twp. 12 R. 18W

Well No. 1 Deman

Heathman Drlg. _____ Company

Heathman Drlg. _____ Contractor

SW SE SW

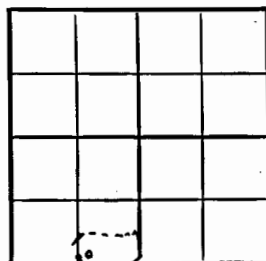FIRST REPORT
SECTION PLAT

_____ Ft. from N. Line

330 _____ Ft. from S. Line

990 _____ Ft. from E. Line

_____ Ft. from W. Line

Ellis County

Location _____

Rig up _____

Drilling and Remarks:

8" @ 160

Anhy 1397

drlg. 1513

RECORD

Cased _____ in., _____ ft.

Sand _____

Gas _____

Oil _____

Total Depth _____

PRODUCTION

1st 24 hrs. Nat. _____

1st 24 hrs. after shot _____

Gas _____ Cu. Ft.

Dry Hole _____

Abandoned _____

Date

DEC 21 1949

19

S. J. LEWIS

Scout

Map No. _____ Sec. 11 Twp. 12 R. 18W


Well No. 1 Wiesner

Heathman Drlg. _____ Company

CORRECTION _____ Contractor

SW SE SW

SECTION PLAT

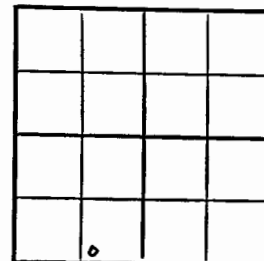

_____ Ft. from N. Line

330 _____ Ft. from S. Line

990 _____ Ft. from E. Line

_____ Ft. from W. Line

Ellis County

Location _____

Rig up _____

Drilling and Remarks:

Reported as

#1 Deman

RECORD

Cased _____ in., _____ ft.

Sand _____

Gas _____

Oil _____

Total Depth _____

PRODUCTION

1st 24 hrs. Nat. _____

1st 24 hrs. after shot _____

Gas _____ Cu. Ft.

Dry Hole _____

Abandoned _____

Date

DEC 28 1949

19

S. J. LEWIS

Scout

KansasMap No. _____ Sec. 11 Twp. 12 R. 18WWell No. 1 Wienes

Heathman Drlg. _____ Company

Contractor

SW SE SW

Feb. 21/54
SECTION PLAT

Ft. from N. Line


330

Ft. from S. Line

990

Ft. from E. Line

Ft. from W. Line

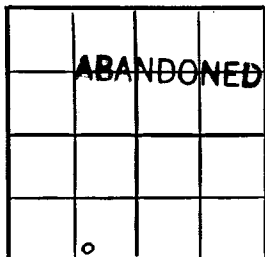

Ellis County

Location _____

Rig up _____

Drilling and Remarks:

8" @ 160

5" @ 3674

Perf 23/3425-30

Sub 2 bbl/s wtr

per hr.

D & A

RECORD

Cased _____ in., _____ ft.

Sand _____

Gas _____

Oil _____

Total Depth 3686

PRODUCTION

1st 24 hrs. Nat. _____

1st 24 hrs. after shot _____

Gas _____ Cu. Ft.

Dry Hole _____

Abandoned L

Date

JAN 11 1950 19

J. E. TYRA

Scout