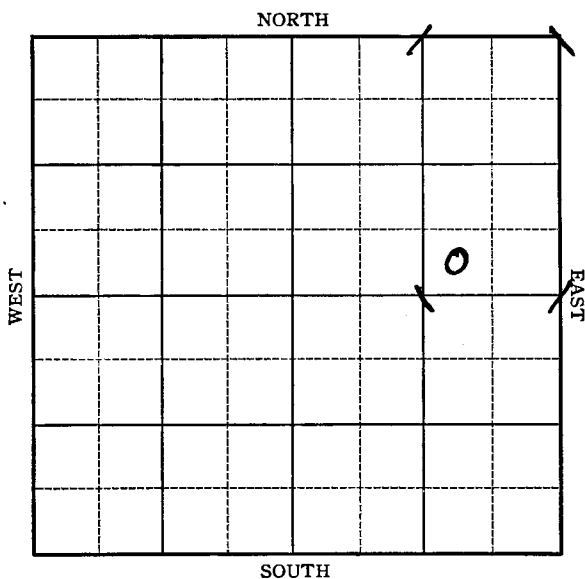


Ellis

KANSAS

Form 51-5M 5-37 Petrol


Section 11 Township 12 Range 18-WWell No. 1 John StaabCompany Carter

Form 252-A-5M-9-37 KANSAS

Ellis

Sec. 11 Twp. 12 R. 18-WWell No. #1 John Staab FarmCarter Company Ft. from N. Line330 Ft. from S. Line990 Ft. from E. Line Ft. from W. Line

Elev. 2154

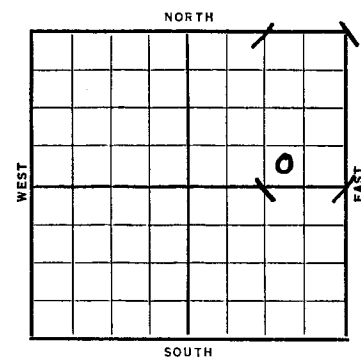

Date	REPORT
1937	
10/6	Mat.
10/15	R U R
10/22	Anhy 1392'. 10" @ 1395'. WOC.
10/29	Drlg. 3243'.
11/5	Drlg. 3274'.
11/12	Drlg. 3615' S.O.
11/19	Sil. 3706'. Cored 3704-16'.
	11' Rec. Spotted Sat. 3706-09'.
	Fair Sat. 3709-15'.
	6" @ 3705'. WOC.
11/26	T.D. 3716'. S.O. Will acidize.
12/3	1500 acid. Pumped 9 bbls. oil
	P.H. after load.
12/10	2000 acid. No Hblp.
	Deepened to 3719' T.D.
12/17	" " " "
12/24	TD 3719' SD.
12/31	P.B. 3505'. WOC.

OVER

1938

1/7 71 shots 3480-3507'.

Sm. S.O. & W.

23 shots 3437-43'.

S.O. & 1/4 B.W. P.H.

P.B. 3495'.

1/14 Drilled plug 3494'.

1500 a cid. 900' water &

sm. S.O.

1/20 " " " "

1/28 " " " "

2/2 6" @ 3705'.

Arb. 3706'.

T.D. 3719'.

ABANDONED

Ellis KANSAS

Map No. _____ Sec. 11 Twp. 12 R. 18WWell No. 1 John StaabCarter Company

Contractor

FIRST REPORT

SECTION PLAT

SW SE NE

Ft. from N. Line

330 Ft. from S. Line990 Ft. from E. Line

Ft. from W. Line

Location _____

Rig up _____

Drilling and Remarks:

Mat

RECORD

Cased _____ in., _____ ft.

Sand _____

Gas _____

Oil _____

Total Depth _____

PRODUCTION

1st 24 hrs. Nat. _____

1st 24 hrs. after shot _____

Gas _____ Cu. Ft.

Dry Hole _____

Abandoned _____

Date

OCT - 6 1937

19

H. D. Hatfield

Scout

Ellis KANSAS

Map No. _____ Sec. 11 Twp. 12 R. 18WWell No. 1 John StaabCarter Oil Company

Contractor

ABANDONED

SECTION PLAT

SW SE NE

Ft. from N. Line

330 Ft. from S. Line990 Ft. from E. Line

Ft. from W. Line

Location _____

Rig up _____

Drilling and Remarks:

RECORD

Cased 6 in., 3705 ft.Sand Arb 3706

Gas _____

Oil _____

Total Depth 3719

PRODUCTION

1st 24 hrs. Nat. _____

1st 24 hrs. after shot _____

Gas _____ Cu. Ft.

Dry Hole _____

Abandoned _____

Date

FEB 2 1938

19

H. D. Hatfield Scout