

State Geological Survey
WICHITA, BRANCH
MAR 17 1938

THE CARTER OIL CO.

INDIVIDUAL WELL RECORD

Lease John Staab Well No. 1 Sec. 11 Twp. 12S Rge. 18W County Ellis State Kansas

Lease No. 34649 A. F. E. No. 3584

Location made 10-5-37 By James Barnett Ground Elevation 2151

Description 330' from S & W lines or C SW SE NE

Drlg. begun 10-13-37 Completed 12-3-37

Contractor Company Tools #54

Address _____

Gas from Consumers Gas Company Paid for by Contractor

Water from Well off Lease Paid for by Contractor

Total depth 3719 ft. Drilled by Rotary 0 - 3719

Deviation hole See Log Drilled Cable Tools None

Initial Prd. None bbls. oil _____ Gvty. _____ Temp. _____

Method of IP _____ in _____ daily hours

Well Producing in Sands from

NAME SAND

Siliceous 3706 ft. to 3719 ft. Casing Pr. _____ Tubing Pr. _____ Choke _____

_____ ft. to _____ ft. Initial Water _____ Initial Gas Prod. _____

_____ ft. to _____ ft. Gravity _____ Tested by _____


_____ ft. to _____ ft. Shot with _____ gts. between _____ Date _____

_____ ft. to _____ ft. Acidized with 500 Dowell XX 3706 - 3716 11-23-37
1000 Dowell XX 3706 - 3716 11-27-37
2000 Dowell XX 3706 - 3716 11-30-37

1500 Morgan 3437-43; 3480-94 1-4-38

CASING AND LINER RECORD

Size	Amount	Wt.	Lapweld or Seamless	Grade	Thread	Set at	Recoverable	Trf Ref	Cement
10 $\frac{3}{4}$	1393	34.24	Smith	X1	BE	1404	None	181(10-22)	528 Incon
6	3722	16.81	SS	X1	SJ)		147(11-18)	
7	5	24	SS	X1	10	3705)	65%	148(11-18)	250 Oilmax
3	3717	9.3	SS	X1	10	3714		298(11-29)	

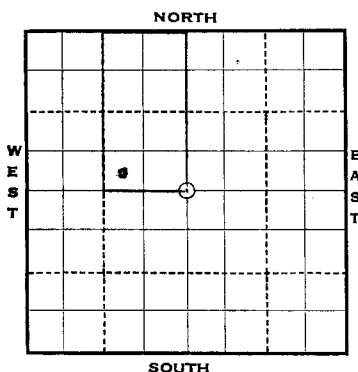

DRY HOLE

11 12 18W
43

