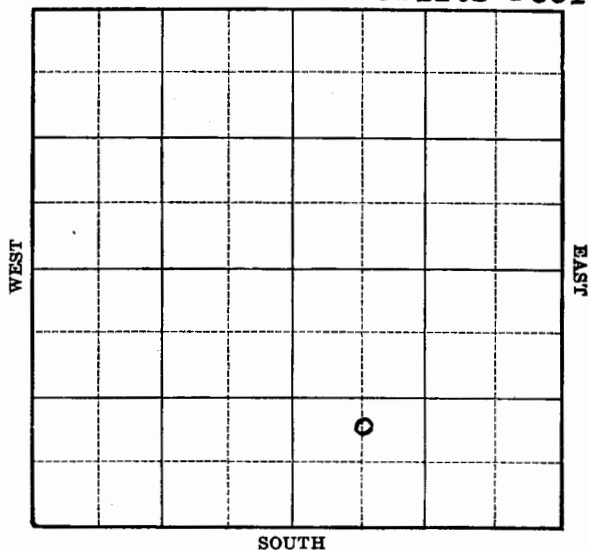


KANSAS

Form 51-5M-7-39-Palace

Ellis

Section 11 Township 12 Range 18-WWell No. #2 WeisnerCompany Carter OilNORTH Loblitz Pool

SOUTH

FORM 252-A 5M 2-40

KANSAS

Ellis

Sec. 11 Twp. 12 R. 18-WWell No. #2 Weisner FarmCarter Oil Company

(Koblitz)

Ft. from N. Line


990

Ft. from S. Line

Ft. from E. Line

660

Ft. from W. Line

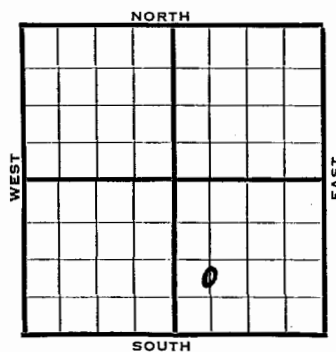Elev. 2171

1940	REPORT
6/12	Location
6/20	R.U.R.
6/27	8" - 245' Drlg. 2421'
7/3	Drlg. 3200'
7/11	Topeka 3130' Lens. 3404'
	Arb. 3699' T.D. 3705' Run 5".
7/18	5" - 3699' RUST.
7/25	T.D. 3723' 5000 acid.
	Pump 2 bbls. water 1 oil per hour
8/2	" " " " " "
8/7	Arb. 3699'
	5" - 3699'
	T.D. 3723'
	500 acid.
	Pump 16 oil & 48 water.
	COMPLETED

Map No. 71 Sec. 11 Twp. 12 R. 18WWell No. 2 Weisner

Carter Oil Company

Contractor

FIRST REPORT

C N L SW SE

SECTION PLAT

Ft. from N. Line

990 Ft. from S. Line

Ft. from E. Line

660 Ft. from W. Line

KOBELITZ POOL

Location X

RECORD

Cased in., ft.Sand Gas Oil Total Depth

PRODUCTION

1st 24 hrs. Nat. 1st 24 hrs. after shot Gas Cu. Ft.Dry Hole Abandoned

Date

JUN 12 1940

S. J. LEWIS Scout

Map No. 71 Sec. 11 Twp. 12 R. 18WWell No. 2 Weisner

Carter Oil Company

Contractor

COMPLETED

C N L SW SE

SECTION PLAT

Ft. from N. Line

990 Ft. from S. Line

Ft. from E. Line

660 Ft. from W. Line

KOBELITZ POOL

Location

RECORD

Cased in., ft.Sand Gas Oil Total Depth 8723

PRODUCTION

1st 24 hrs. Nat. 1st 24 hrs. after shot Gas Cu. Ft.Dry Hole Abandoned

Date

AUG 7 1940 19

S. J. LEWIS Scout