

Ellis

Ellis



Form 51-5M-11-38-Palace

Sec. 12 Twp. 12 R. 18-WSection 12 Township 12 Range 18-WWell No. #1 JensenCompany Courtney DavisWell No. #1 Jensen FarmCourtney Davis Company
(Walters)

Ft. from N. Line

330 Ft. from S. Line990 Ft. from E. Line

Ft. from W. Line

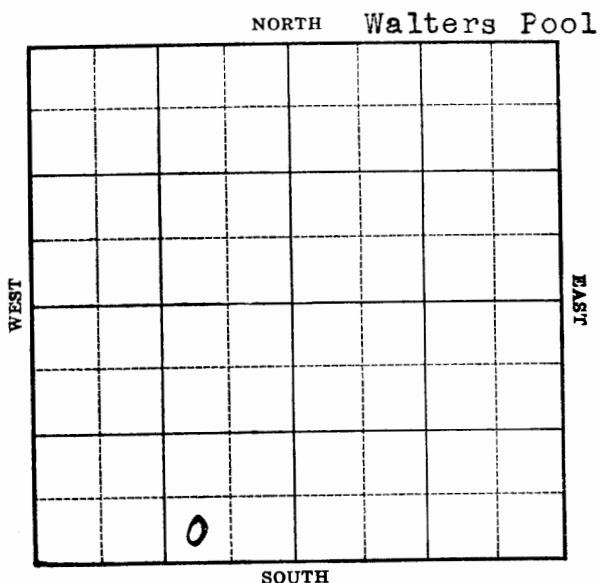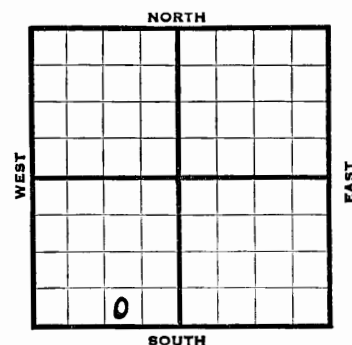

1939	REPORT
3/8	Cellar & Pits.
3/17	" " "
3/24	" " "
3/31	B.R.R.
4/7	"
4/14	S. H.
4/21	12" - 103' Drlg. 3215'
4/28	7" - 3686' T.D. 3696' 850' oil in 6 hrs.
5/5	1400' oil 10 hrs. 3500 acid. No help. Pump 5 bbls. per hour after head. Drlg. 3200'
5/12	T.D. 3705' 900' oil. 9000 acid. Pump 23 bbls. per hour. Shot 120 qts.
	Split casing.
5/19	Cementing casing.
5/26	T.D. 3720' Run tubing.

523015

1939

5/31

Arb. 3686'

7" --- 3686'

T.D. 3720'

3500 acid.

9000 acid.

Potential 736 bbls, Pump.

COMPLETED

Ellis

KANSAS

Map No. 71 Sec. 12 Twp. 12 R. 18WWell No. 1 Jensen

Courtney Davis

Company

Contractor

FIRST REPORT

SW SE SW

Ft. from N. Line

330 Ft. from S. Line990 Ft. from E. Line

Ft. from W. Line

SECTION PLAT

~~WALTERS~~ POOL

Walters

Location

RECORD

Cased _____ in., _____ ft.

Sand _____

Gas _____

Oil _____

Total Depth _____

PRODUCTION

1st 24 hrs. Nat. _____

1st 24 hrs. after shot _____

Gas _____ Cu. Ft.

Dry Hole _____

Abandoned _____

Date

MAR 8 - 1939

19

H. D. Hatfield Scout

Ellis

KANSAS

Map No. _____ Sec. 12 Twp. 12 R. 18WWell No. 1 Jensen

Courtney Davis

Company

Contractor

COMPLETED

SW SE SW

Ft. from N. Line

330 Ft. from S. Line990 Ft. from E. Line

Ft. from W. Line

SECTION PLAT

WALTERS POOL

Location

RECORD

Cased _____ in., _____ ft.

Sand _____

Gas _____

Oil _____

Total Depth 8720

PRODUCTION

1st 24 hrs. Nat. _____

1st 24 hrs. after shot _____

Gas _____ Cu. Ft.

Dry Hole _____

Abandoned _____

Date

MAY 31 1939

19

S. J. LEWIS

Scout