



Section 12 Township 12S Range 18W
 Well No. #1 Jensen
 Company Aylward et al

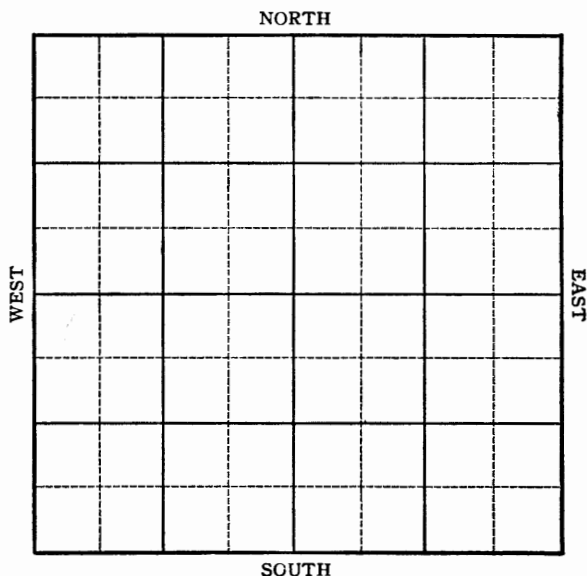

Sec. 12 Twp. 12 R. 18W
 Well No. #1 Jensen Farm
Aylward et al Company
Glathart

990 Ft. from N. Line
 Ft. from S. Line
990 Ft. from E. Line
 Ft. from W. Line

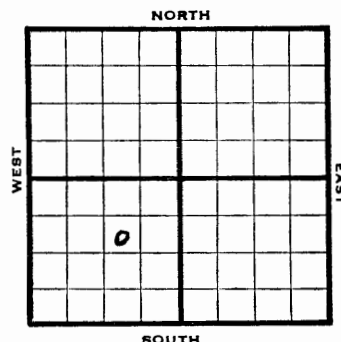

SW NE SW

1945

R E P O R T

3/21 Derrick
 3/29 "
 4/5 Drlg. 1240
 4/12 8" @ 1389
 Anhy 1389
 Drlg. 2675
 4/20 Lans 3404
 Arb 3658
 TD 3663 Sat.
 5" @ 3659 RUST
 4/27 Swab 9 oil per hr
 5/9 Arb 3658
 5" @ 3659
 TD 3663
 1000 acid.
 Pump 480 Pot.
 Grav. 33.4

COMPLETED

Pool Name GlatthartMap No. 12 Sec. 12 Twp. 12 R. 18WWell No. 1 JensenAylward etal CompanyFIRST REPORT Contractor

SW NE SW

SECTION PLAT

990 Ft. from N. Line Ft. from S. Line990 Ft. from E. Line Ft. from W. Line

Ellis County

Location Cased in., ft.Sand Gas Oil Total Depth

PRODUCTION

1st 24 hrs. Nat. 1st 24 hrs. after shot Gas Cu. Ft.Dry Hole Abandoned

Date

MAR 21 1945 19 S. J. LEWIS ScoutKansas Pool Name GlatthartMap No. 71 Sec. 12 Twp. 12 R. 18WWell No. 1 JensenAylward etal CompanyCOMPLETED Contractor

SW NE SW

SECTION PLAT

990 Ft. from N. Line Ft. from S. Line990 Ft. from E. Line Ft. from W. Line

Ellis County

Location

RECORD

Cased in., ft.Sand Gas Oil Total Depth 366'

PRODUCTION

1st 24 hrs. Nat. 1st 24 hrs. after shot Gas Cu. Ft.Dry Hole Abandoned

Date

MAY 9 1945 19 S. J. LEWIS Scout