

Sec. 12 Twp. 12 R. 18W

Well No. 2 Jensen Farm

Aylward et al Company

Glathart


1880 Ft. from N. Line

Ft. from S. Line

920 Ft. from E. Line

Ft. from W. Line

C W L SE SW Elev. 2164

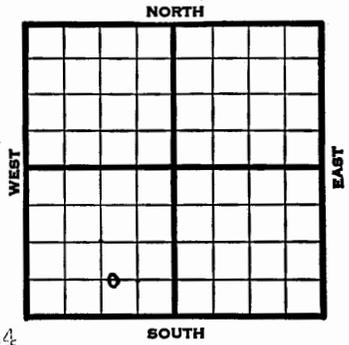


Section 12 Township 12 Range 18W

Well No. 2 Jensen

Company Aylward et al

NORTH

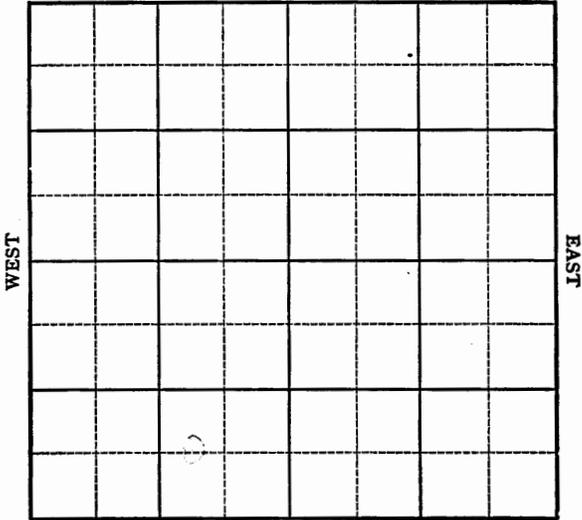

SOUTH

REPORT

1945

5/9 Derrick
 5/17 RUR
 5/24 Anhy 1400
 8" @ 1440
 Drlg. 2315
 5/31 Drlg. 3613
 6/8 Arb. 3684-5" @ 3684 TD 3689
 7 oil p.h.
 6/20 Arb 3684
 5" @ 3684
 TD 3689
 1000 acid.
 Est. 200 Pot.
 Grav. 31.3

COMPLETED

Kansas Pool Name Glathart

Map No. _____ Sec. 12 Twp. 12 R. 18 W

Well No. 2 Jensen

Aylward etal Company

COMPLETED Contractor
C W L SE SW E. 12/64

SECTION PLAT

1880 Ft. from N. Line

_____ Ft. from S. Line

920 Ft. from E. Line

_____ Ft. from W. Line

Ellis County

Location _____

Rig up _____

Drilling and Remarks:

3684
5" C 3684
1000 cu. ft.
Est. 200 P.D.

31 3/4

RECORD

Cased _____ in., _____ ft.

Sand _____

Gas _____

Oil _____

Total Depth 3689

PRODUCTION

1st 24 hrs. Nat. _____

1st 24 hrs. after shot _____

Gas _____ Cu. Ft.

Dry Hole _____

Abandoned _____

Date

JUN 20 1945 19 _____ S. J. LEWIS Scout

Kansas Pool Name Glathart

Map No. 71 Sec. 12 Twp. 12 R. 18 W

Well No. 2 Jensen

Aylward etal Company

FIRST REPORT Contractor
C W L SE SW

SECTION PLAT

1880 Ft. from N. Line

_____ Ft. from S. Line

920 Ft. from E. Line

_____ Ft. from W. Line

Ellis County

Location _____

Rig up _____

Drilling and Remarks:

derrick

RECORD

Cased _____ in., _____ ft.

Sand _____

Gas _____

Oil _____

Total Depth _____

PRODUCTION

1st 24 hrs. Nat. _____

1st 24 hrs. after shot _____

Gas _____ Cu. Ft.

Dry Hole _____

Abandoned _____

Date

MAY 9 1945 19 _____ S. J. LEWIS Scout