

Sec. 12 Twp. 12 R. 18W

Well No. #3 Jensen "A" Farm

Aylward Prod. et al Company


Glathart

330 Ft. from N. Line

Ft. from S. Line

660 Ft. from E. Line

Ft. from W. Line

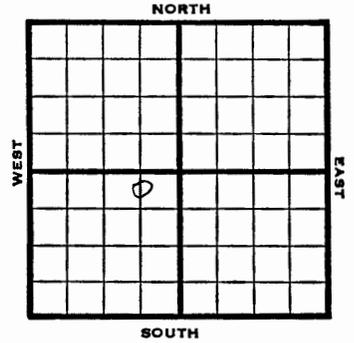


CNL NE SW

1946 Elev. 2133' REPORT

2/6	Location
2/14	"
2/21	"
2/28	Anhy 1385' 8" - 1390' Drlg. 1509'
3/7	Lans. 3382' Arb. 3643-44' T.D. 5" - 3643' RUST.
3/14	1500' oil 1/2 hour.
3/21	" " "
3/28	" " "
4/4	" " "
4/10	Pump 7½ oil-7% W PH 24 hrs.
4/17	Arb. 3643 5" @ 3643 TD 3644 Pump 528 oil plus 7% wtr. pot. Grav. 27.0

COMPLETED

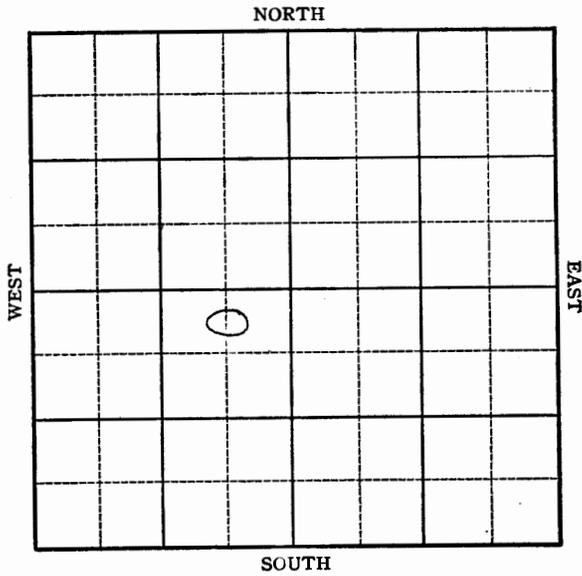

KANSAS Kansas Pool Name Glathart
Map No. 71 Sec. 12 Twp. 12 R. 18W
Well No. 3 Jensen "A"

Aylward Prod. etal. Company

COMPLETED

Contractor

E. J. 2633

C N L NE SW


SECTION PLAT

330 Ft. from N. Line

Ft. from S. Line

660 Ft. from E. Line

Ft. from W. Line

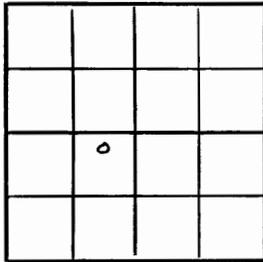

Ellis County

Location _____

Rig up _____

Drilling and Remarks:

2 3/4" 3643
5" @ 8643
Pump 528 oil
7 7/8" NW 1/4

27 2/42

RECORD

Cased _____ in., _____ ft.

Sand _____

Gas _____

Oil _____

Total Depth 3644

PRODUCTION

1st 24 hrs. Nat. _____

1st 24 hrs. after shot _____

Gas _____ Cu. Ft.

Dry Hole _____

Abandoned _____

Date

APR 17 1946 19 S. J. LEWIS Scout

KANSAS Kansas Pool Name Glathart
Map No. 71 Sec. 12 Twp. 12 R. 18W
Well No. 3 Jensen "A"

Aylward Prod. etal. Company

FIRST REPORT

Contractor

C N L NE SW


SECTION PLAT

330 Ft. from N. Line

Ft. from S. Line

660 Ft. from E. Line

Ft. from W. Line

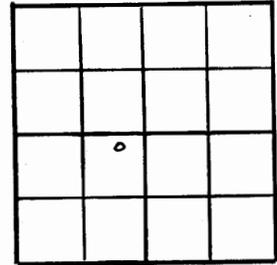

Ellis County

Location X

Rig up _____

Drilling and Remarks:

RECORD

Cased _____ in., _____ ft.

Sand _____

Gas _____

Oil _____

Total Depth _____

PRODUCTION

1st 24 hrs. Nat. _____

1st 24 hrs. after shot _____

Gas _____ Cu. Ft.

Dry Hole _____

Abandoned _____

Date

FEB 6 1946 19 S. J. LEWIS Scout