


WELL LOG BUREAU KANSAS GEOLOGICAL SOCIETY
412 Union National Bk. Bldg., Wichita, Kansas



Company - AYLWARD PROD. CO., ET AL
Farm - Jensen "B" No. 2.

SEC. 12 T. 12 R. 18 W
NW 1/4 SE 2310 FSL and 2410 FEL
KCC Record

Total Depth. 3641
Comm. 3-7-46 Comp. 3-20-46
Shot or Treated.
Contractor. Aylward Drlg. Co.
Issued. 4-13-46

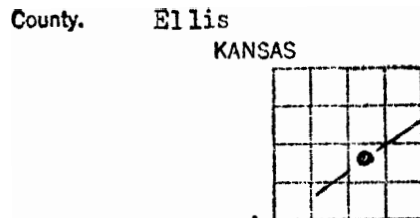

CASING:
8" 1340' Cem.

Elevation. 2091^{ft}
Production. Dry

Figures Indicate Bottom of Formations.

shale	0-840
sand	1010
shale & shells	1095
shale	1270
red bed & shale	1335
anhydrite	1375
shale & shells	1715
shale	1735
silt	1880
shale & shells	2000
shale & lime	2110
shale	2180
lime	2210
shale	2270
lime	2345
lime & shale	2425
lime	2460
shale	2570
lime & shale	2635
lime	2705
shale	2730
shale & shells	2840
shale	2930
lime brkn	2995
shale & lime	3125
lime	3360
lime sft	3370
lime & shale	3405
lime	3600
lime & chert	3605
shale	3610
shale & lime	3620
conglomerate	3641
Total Depth	

Well log bureau sent in following
tops on their list of 5-11-46

Tops:
Anhydrite 1335
Lansing 3339
Re-worked Arb. 3630
Arb. 3635