

Ellis KANSAS

Section 12 Township 12 Range 18WWell No. 1 Jensen "D"Company Trans-Era



Ellis KANSAS

SEC. 12 TWP. 12 RANGE 18 W

WELL NO. # 1 Jensen "D" FARM

COMPANY Trans-Era

CONTRACTOR

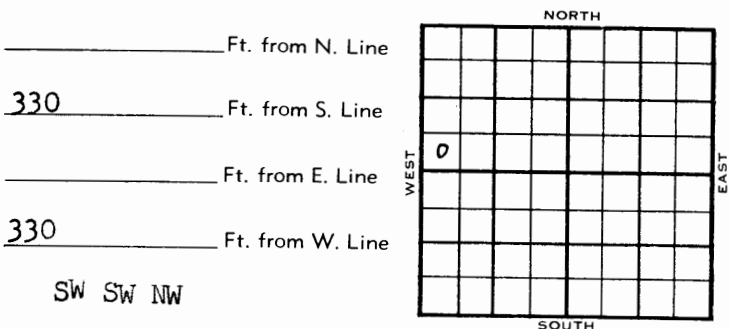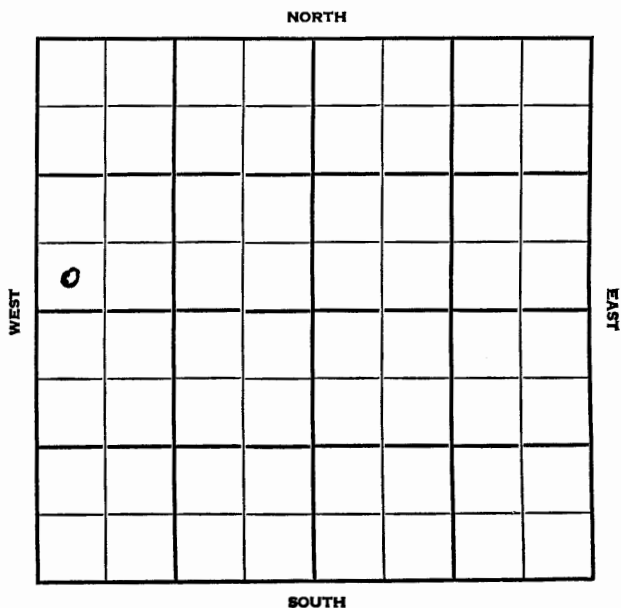

1954	ELEVATION 2093'	REPORT
10/20	Spud 10-5-54 8" @ 187' Heeb 3293' KC 3338' DST 3380-3440 open 1 hr rec 90' mud SO 625# Simp. 3594' Arb. 3612' TD 3617' 5" @ 3614' WOC	
12/15	Spud 10-5-54 Oil Well TD 3617' 8" @ 187' Heeb 3293', KC 3338' DST 3380'-3440' opn 1 hr, rec 90' Mud 625# Simp 3594' Arb. 3612' TD 3617' 5" @ 3614' CO to 3617' FU 1450' oil 25% Wtr. 6 hr. P/ 50 bo 150 bw. 24 hr. Comp 25 bopd. 75 bw.	COMPLETED

FABEN GLSTRAP

CONFIDENTIAL